IREDELL COUNTY HEALTH DEPARTMENT

STATESVILLE 704-878-5305 MOORESVILLE 704-664-5281

IMPROVEMENT PERMIT / AUTHORIZATION TO CONSTRUCT / OPERATION PERMIT / EXISTING SYSTEM INSPECTION

PERMIT# 71514 PIN# 476157 2733 DATE 1-29-98

OWNER OR CONTRACTOR Dale W. McNeely PHONE: Business Home 528 5898

ADDRESS 1005 Bethesda Rd Statesville N.C.

LOCATION 70E TR Bethesda Rd on left before end

SUBDIVISION BLOCK / SECTION LOT LOT AREA 10.2 Acres SITE CLASS. PS DESIGN FLOW 360 L.T.A.R. .3

Septic Tank: 1000 Gallons; STB 1012 Date 12-9-98

Pump Tank: Gallons; PT Date

Pump Make: Model Serial No.

Nitrification Field: No Fields 1 Square Feet 1200 Linear Feet 400

No Lines 4 Trench Width 36" Max Trench Bottom Depth 36" Gravel Depth 12"

☐ New System ☐ Repair System Type: I, II, III, IV, V, VI

System Description: Conv. Gravity

Repair System Description: " "

Maintenance Agreement Required: ☐ Yes ☒ No

☐ House/Mod. Home ☒ Mobile Home ☐ Business ☐ Other

No. Bedrooms 3 No. Bathrooms 2 No. Employees

Water Supply: ☒ Individual ☐ Public ☐ Community


☐ Slab ☒ Crawl Space ☐ Basement w/plumbing ☐ Basement wo/plumbing

Comments:/Conditions:

Property line


10'

INITIAL SITE SKETCH

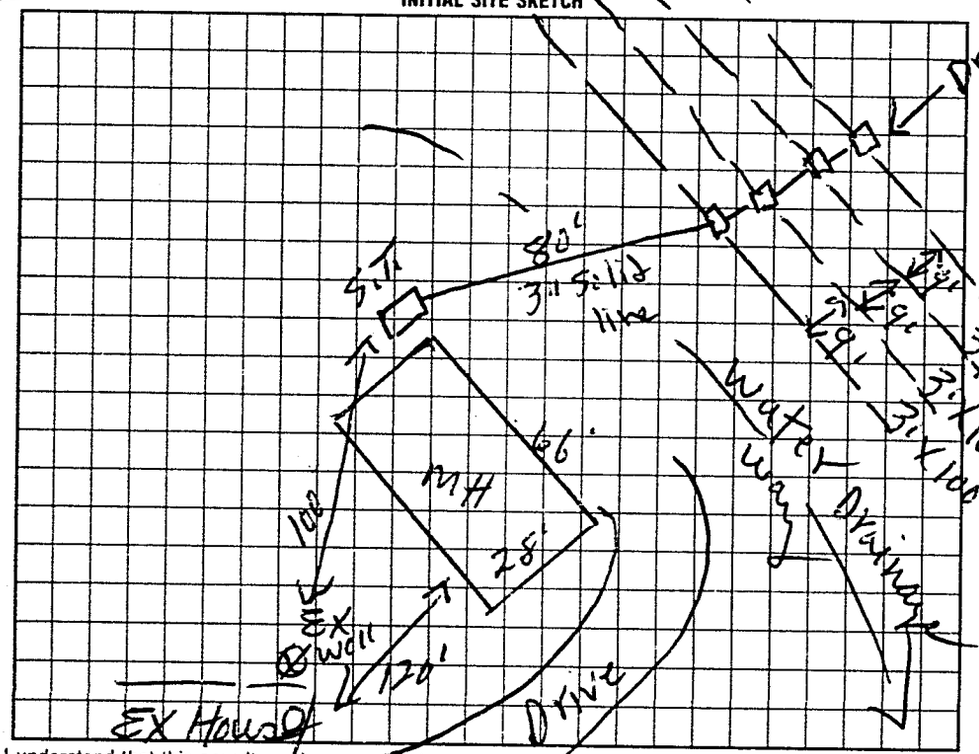

Comments:/Conditions:

AS BUILT SKETCH

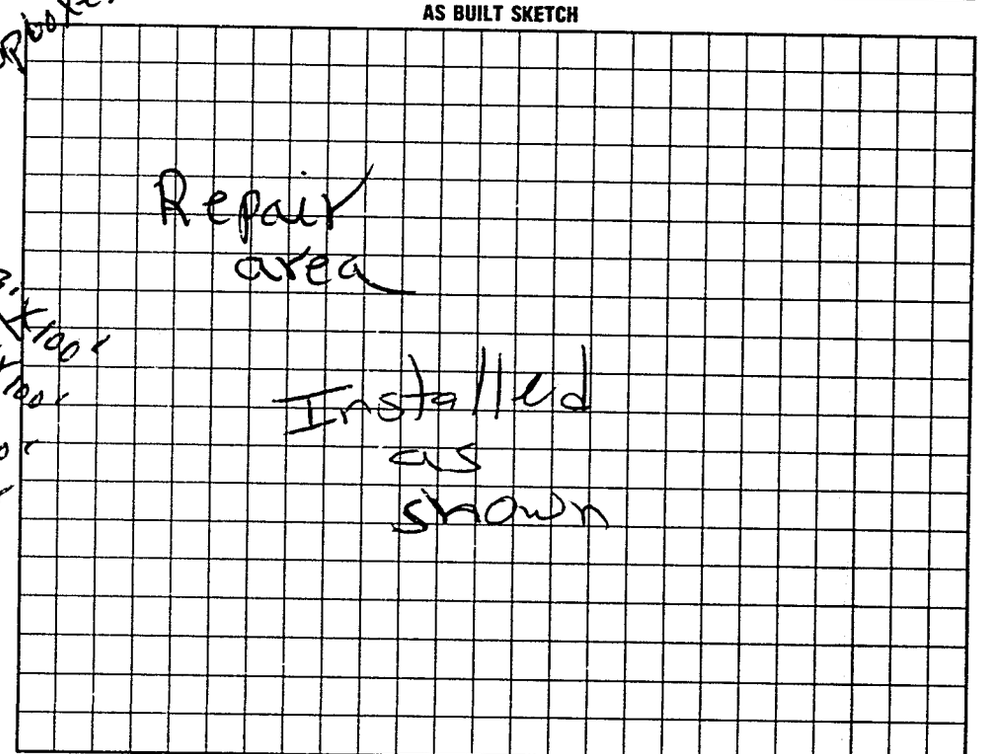

Bethesda Rd

I understand that this permit can be suspended or revoked if any false information is supplied toward securing the permit/any unauthorized changes are made to the site/any unauthorized changes are made in the installation of the system. Improvement Permit with plat valid without expiration. Improvement Permit with site plan valid for sixty months. Authorization to Construct is valid for a period equal to that of Improvement Permit – not to exceed sixty months.

Signed: Dale McNeely date 1-29-98 Installed by: Steve Jordan

Improvement Permit by: P. C. Moore date 1-29-98 Operation Permit by: Mark Cox RS date 3-23-98

Authorization to Construct by: P. C. Moore date 1-29-98 Existing System Inspection by: date

HEALTH DEPT. COPY: WHITE INSPECTION COPY (FINAL): GREEN OWNER COPY (FINAL): YELLOW INSPECTION COPY (INITIAL): PINK OWNER COPY (INITIAL): GOLD

8 2 9 6 8 0