IREDELL COUNTY HEALTH DEPARTMENT

STATESVILLE 704-878-5305 MOORESVILLE 704-664-5281

41891

IMPROVEMENT PERMIT / CERTIFICATE OF COMPLETION / OPERATION PERMIT / EXISTING SYSTEM INSPECTION

PROPERTY DESCRIPTION NO. 14609 DATE 7-2-93 TAX MAP NO. 5B-4 46 4

OWNER OR CONTRACTOR Giles Cochran Jr. PHONE: Business Home

ADDRESS 5000 Huntersville Concord Rd Huntersville N.C.

LOCATION 115 Amity Oswalt Rd Past Brawley Rd 300' on rt

SUBDIVISION Cochran Property BLOCK / SECTION LOT 2 LOT AREA 2.661 acres SITE CLASS. P3. L.T.A.R. .4

Water Supply: ☑ Individual ☐ Community ☐ Public

Septic Tank: 1000 Gallons; STB 358 Date 5-10-93

Pump Tank: Gallons; PT Date

Nitrification Field: No Fields 1 Square Feet 900 Linear Feet 300

No Lines 3 Trench Width 36 Trench Depth 24 Gravel Depth 12

☑ New System ☐ Repair System Type: I. II. IV. V. VI

System Description: Conv. Gravity

Repair System Description: " "

Maintenance Agreement Required: ☐ Yes ☑ No

☐ House/Mod. Home ☑ Mobile Home ☐ Business ☐ Other

No. Bedrooms 3 No. Bathrooms 2 No. Employees

Garbage Disposal: ☐ Yes ☑ No

Auto. Dishwasher: ☐ Yes ☐ No


Auto. Washing Machine: ☑ Yes ☐ No

Other


☐ Slab ☑ Crawl Space ☐ Basement w/plumbing ☐ Basement wo/plumbing

Comments

INITIAL SITE SKETCH

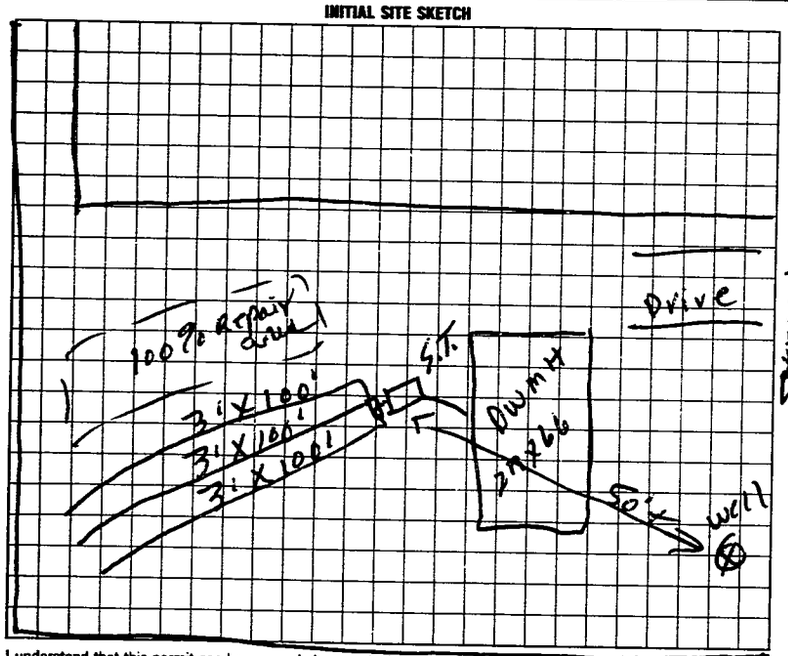

AS BUILT SKETCH

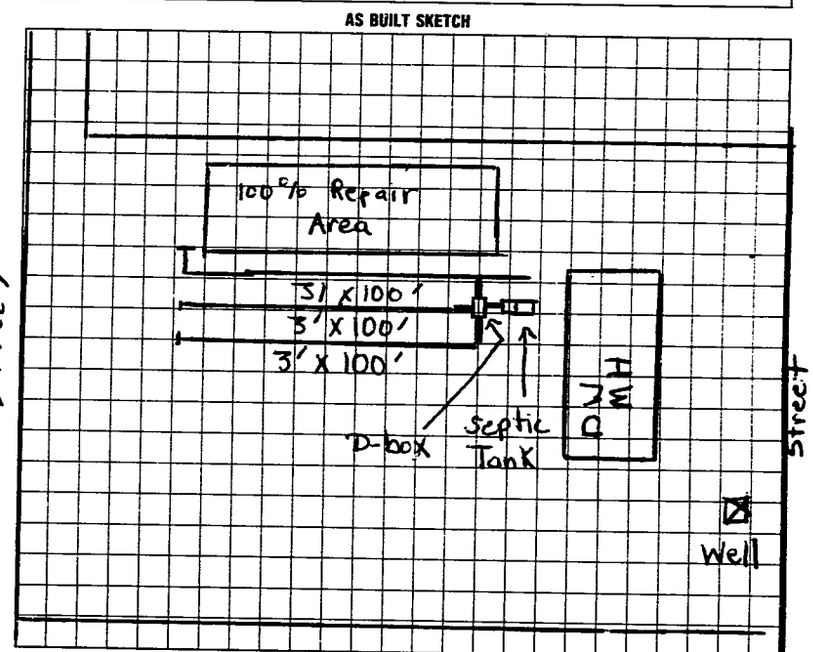

I understand that this permit can be suspended or revoked if any false information is supplied toward securing the permit/any unauthorized changes are made to the site/any unauthorized changes are made in the installation of the system. Improvement Permit is valid for 60 months from date of issuance.

Signed: Giles Cochran Jr./Nina Cochran Installed by: Donald Zachary

Improvement Permit by: R. C. Moore date 7-2-93 Certificate of Completion by: Michael F. Dennis for C. Moore date 7-20-93

Existing System Inspection by: date Operation Permit by: date

HEALTH DEPT. COPY: WHITE INSPECTION COPY (FINAL): GREEN OWNER COPY (FINAL): YELLOW INSPECTION COPY (INITIAL): PINK OWNER COPY (INITIAL): GOLD