IREDELL COUNTY HEALTH DEPARTMENT

STATESVILLE 704-878-5305 MOORESVILLE 704-664-5281

IMPROVEMENT PERMIT / AUTHORIZATION TO CONSTRUCT / OPERATION PERMIT / EXISTING SYSTEM INSPECTION

PERMIT # 169033 PIN # 4761733246 DATE 6/27/12

OWNER or APPLICANT STACY OVERCASH PHONE: Business 704-737-7070 Home: 704-538-7176

OWNER or APPLICANT ADDRESS 1240 OSTWALT AMITY RD - CLEVELAND, NC 27013

LOCATION / DIRECTIONS 21/115 N - TR OSTWALT AMITY - # 1240 OSTWALT AMITY

SUBDIVISION — BLOCK / SECTION — LOT # — LOT AREA 13.7AC DESIGN FLOW 250 GPD L.T.A.R. .250 GPD/FT2

2ND

Septic Tank 2 @ 1000 Gallons: STB 1012 Date 8-26-13

~~Pump Tank~~ 1000 Gallons: PT 1012 Date 8-4-13

Pump Make — Model — Serial # —

Nitrification Field No Fields 1 No Lines 3 Linear Feet 336

Trench Width 36" Max. Trench Bottom Depth 36" Gravel Depth 12"

☒ New System ☐ Repair ☐ Expansion System Type I (II) III IV V VI

System Description: ~~GRAVITY CONVENTIONAL~~ 25%

Repair System Description: SAME

Maintenance Agreement Required ☐ YES ☒ NO

☒ GRAVITY ☐ PRESSURE

☐ Residence No. Bedrooms —

☒ Business No. Persons —

☐ Other No. Employees —

☒ Slab ☐ Crawl Space

☐ Basement w/plumbing ☐ Basement w/o plumbing

Water Supply: ☒ Private ☐ Public ☐ Community

Comments / Conditions 10 GALLONS PER DOG RUN. - 20 RUNS PLUS 2 EMPLOYEES = 250 GPD

Comments / Conditions 1) SCREENS TO BE INSTALLED IN FLOOR DRAINS AT INLET PIPE TO CATCH HAIR. 2) RAIN WATER MUST BE PREVENTED FROM ENTERING WASTEWATER SYSTEM. 3) TWO 1000 GALLON TANKS WITH ACCESS OPENINGS EXTENDED TO GRADE INSTALLED IN SERIES.

4) TANK #1 TO RECEIVE ONLY PROCESS WASTEWATER GENERATED AT DOG KENNEL. TANK #2 TO RECEIVE EFFLUENT FROM TANK #1 AND SEWAGE FROM BATHROOM.


5) FILTER ON TANK #1 SHALL BE FITTED WITH FILTER TO CATCH ANIMAL HAIR.

6) ONLY GRAVEL CONVENTIONAL OR ACCEPTED TYPE SYSTEM TO BE INSTALLED WITH NO REDUCTION.


7) SOAPS, SHAMPOOS, AND OTHER CLEANING AGENTS SHALL BE BIODEGRADABLE. SYNTHETIC PESTICIDES AND INSECTICIDES SHALL NOT BE DISCHARGED IN SEPTIC SYSTEM.

1" = 100'

INITIAL SITE SKETCH

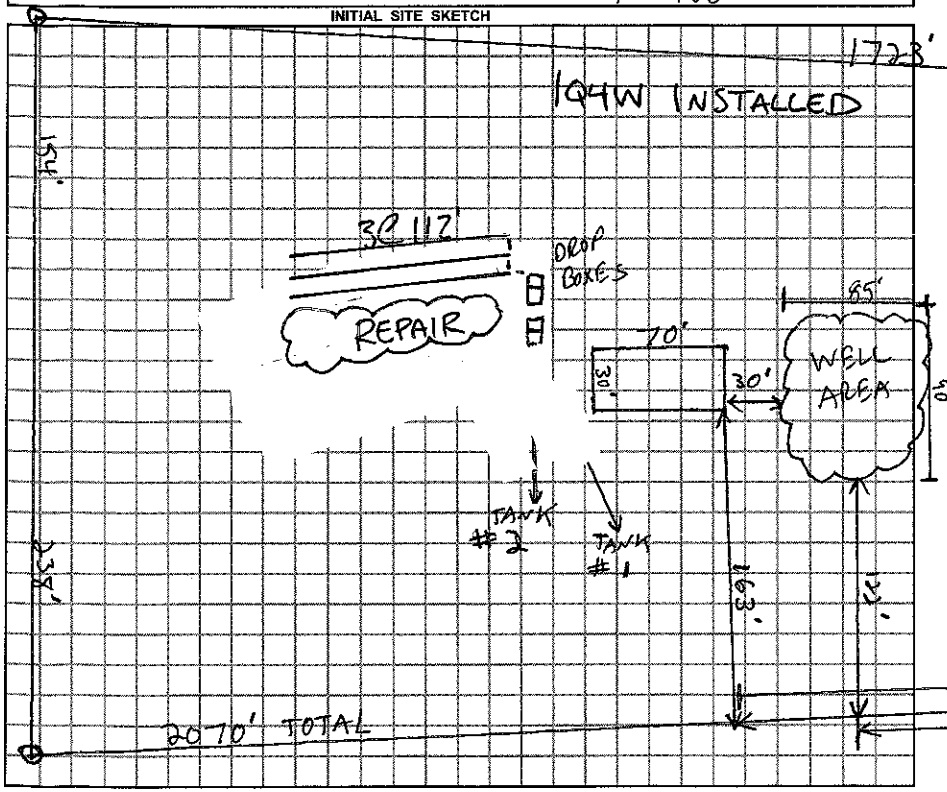

AS BUILT SKETCH

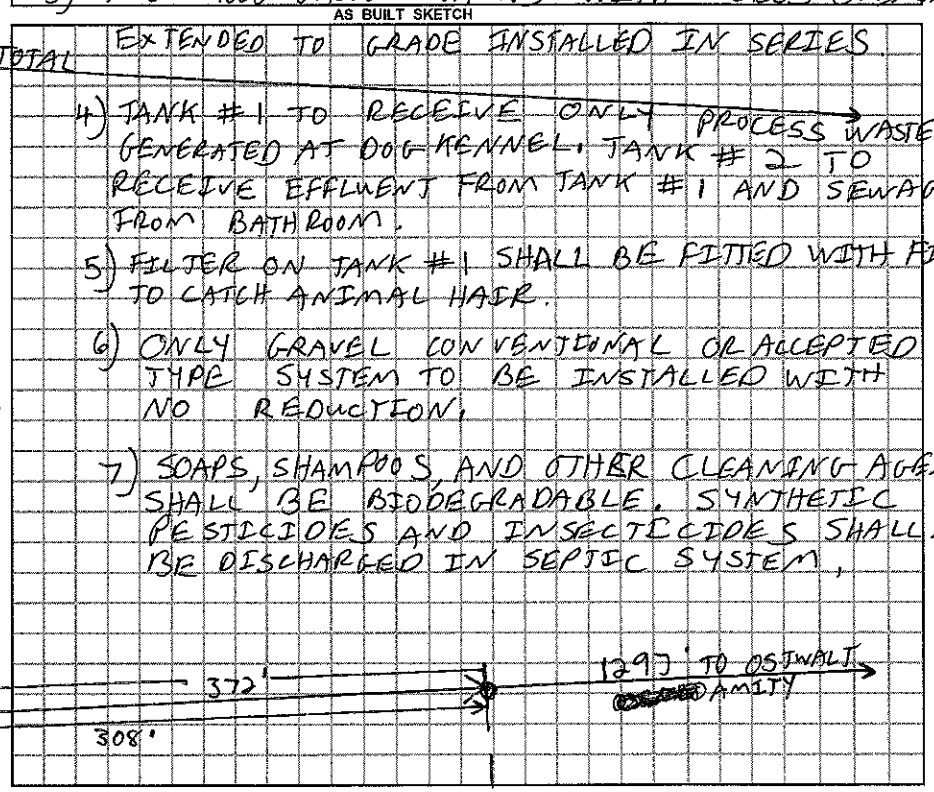

Permit can be suspended or revoked if any false information is supplied toward securing the permit / any unauthorized changes are made to the site / any unauthorized changes are made in the installation of the system.

☐ *IMPROVEMENT PERMIT w / plat valid without expiration.* ☒ *IMPROVEMENT PERMIT w / site plan valid for 60 mos.* ☒ *AUTHORIZATION TO CONSTRUCT valid for period equal to IMPROVEMENT PERMIT-not to exceed 60 mo.*

Owner / Applicant Signature: Stacy Overcash Date 6/28/12

Improvement Permit by: C. Brad Teem Date 6/27/12

Authorization to Construct by: C. Brad Teem WAIVED 2/19/13

Installed by: Tommy Fry

Operation Permit by: RAEG Date: 11-21-13

Existing System Inspected by: — Date: —

YOU SHOULD CONTACT A LOCATOR SERVICE PRIOR TO ANY EXCAVATION.

WHITE COPY Environmental Health YELLOW COPY (Final) Owner / Applicant PINK COPY (Initial) Owner / Applicant