IREDELL COUNTY HEALTH DEPARTMENT

STATESVILLE 704-878-5305 MOORESVILLE 704-664-5281

IMPROVEMENT PERMIT / AUTHORIZATION TO CONSTRUCT / OPERATION PERMIT / EXISTING SYSTEM INSPECTION

PERMIT# REPAIR PIN# 4761-74-6429 DATE 3-28-03

OWNER OR CONTRACTOR JAMES R. BENFIELD PHONE: Business Home 704-528-3329

ADDRESS 1251 OSTWALT AMITY RD, CLEVELAND, NC 27013-8935

LOCATION US 21 SOUTH, TL OSTWALT AMITY ROAD, 0.6 MILE ON LEFT PAST BETHESDA ROAD

SUBDIVISION BLOCK / SECTION LOT LOT AREA 1.6 ACRE SITE CLASS PS DESIGN FLOW 240 L.T.A.R. EXISTING

Septic Tank: ~~EXISTING~~ Gallons; STB Date

Pump Tank: Gallons; PT Date

Pump Make: Model Serial No.

Nitrification Field: No Fields 1 Square Feet 210 Linear Feet 70

No Lines ONE Trench Width 36" Max Trench Bottom Depth 36" Gravel Depth 18"

☐ New System ☑ Repair System Type: I (II) III, IV, V, VI

System Description: CONVENTIONAL GRAVITY

Repair System Description: CONVENTIONAL GRAVITY

Maintenance Agreement Required: ☐ Yes ☑ No

☐ House/Mod. Home No. Bedrooms 2

☑ Mobile Home No. Bathrooms 2

☐ Business No. Employees

☐ Other


☐ Slab ☑ Crawl Space ☐ Basement w/plumbing ☐ Basement wo/plumbing

Water Supply: ☑ Individual ☐ Public ☐ Community WELL


Comments:/Conditions: (1) INSTALL NEW DROP BOXES AS SHOWN INTERCEPTING EXISTING DRAIN LINE (2) USE 18 INCHES STONE IN NEW TRENCH (3) THIS PERMIT SERVES AS "NOTICE of VIOLATION" SYSTEM TO BE REPAIRED BY 4-28-03

Comments:/Conditions:

INITIAL SITE SKETCH

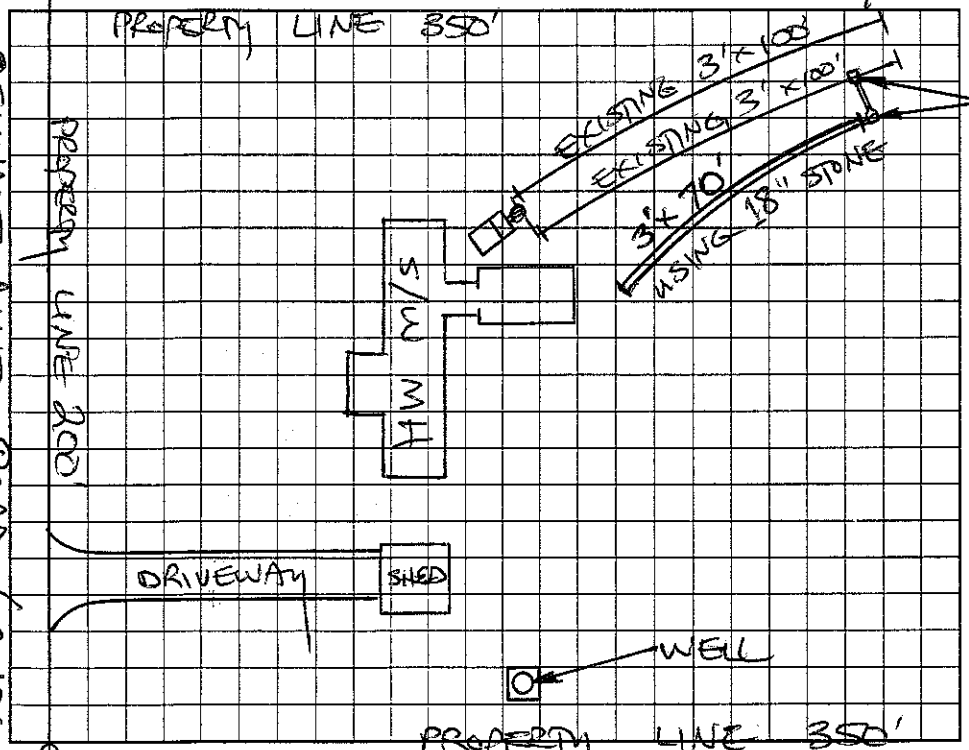

AS BUILT SKETCH

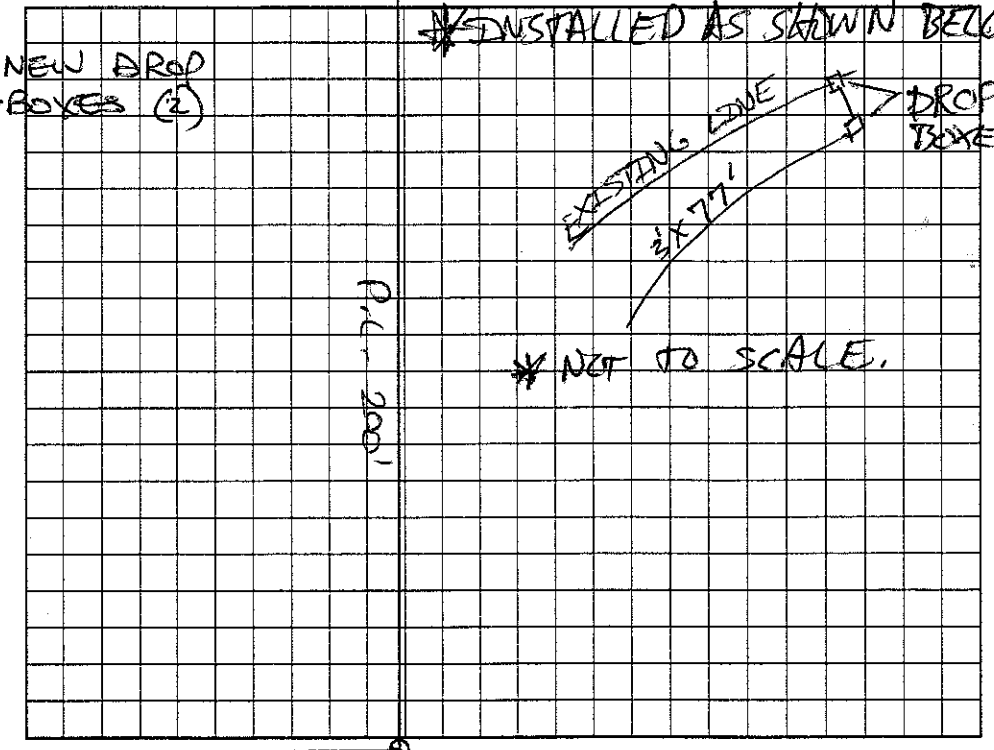

Permit can be suspended or revoked if any false information is supplied toward securing the permit/any unauthorized changes are made to the site/any unauthorized changes are made in the installation of the system. Improvement Permit with plat valid without expiration. Improvement Permit with site plan valid for sixty months. Authorization to Construct is valid for a period equal to that of Improvement Permit – not to exceed sixty months.

Signed: X James R Benfield date 3-28-03 Installed by: SAMMY STUMMAKER 4-16-03

Improvement Permit by: STEVE HEDRICK date 3-28-03 Operation Permit by: Patrick Mitchell date 04/16/03

Authorization to Construct by: STEVE HEDRICK date 3-28-03 Existing System Inspection by: date

HEALTH DEPT. COPY: WHITE OWNER COPY (FINAL): YELLOW OWNER COPY (INITIAL): PINK