THIS PERMIT VOIDS PREVIOUSLY ISSUED 8-24-2001

IREDELL COUNTY HEALTH DEPARTMENT

STATESVILLE 704-878-5305 / 05, 00 MOORESVILLE 704-664-5281

IMPROVEMENT PERMIT / AUTHORIZATION TO CONSTRUCT / OPERATION PERMIT / EXISTING SYSTEM INSPECTION

PERMIT# 101705 PIN# 4761-87-7737 DATE 6-26-02

OWNER OR CONTRACTOR CHARLOTTE HARRELL PHONE Business Home 704-278-3186

ADDRESS P.O. BOX 296, CLEVELAND, NC 27013

LOCATION US 70 E, TR ~~PEARSON~~ TRIPLETT RD, TR HEMLOCK, TR BLUE SPRUCE, BEAR RIGHT TO END

SUBDIVISION BLOCK / SECTION LOT LOT AREA 0.5 ACRES SITE CLASS PS DESIGN FLOW 360 L.T.A.R. 0.30 GPD/FT²

Septic Tank: 1000 Gallons: STB 750 Date 03/01/02
Pump Tank: 1000 Gallons: PT 363 Date 06/18/02
Pump Make: ZOELLER Model BN52A Serial No 152-0005
Nitrification Field: No Fields 1 Square Feet EQ TO 1200 Linear Feet 300
No Lines FOUR Trench Width 36" Max Trench Bottom Depth 36" Gravel Depth N/A

☒ New System ☐ Repair System Type: I, II, (III), IV, V, VI
System Description: 25% REDUCTION, PUMP
Repair System Description: 50% REDUCTION, LOW-PRESSURE
Maintenance Agreement Required: ☐ Yes ☒ NO

☒ House/Mod. Home No. Bedrooms 3
☒ Mobile Home No. Bathrooms 2
☐ Business No. Employees
☐ Other


☐ Slab ☒ Crawl Space ☐ Basement w/plumbing ☐ Basement wo/plumbing

Water Supply: ☒ Individual ☐ Public ☐ Community WELL

Comments/Conditions: ① INSTALL 25% REDUCTION SYSTEM IN FOUR EQUAL LENGTH LINES ON CONTOUR AS FLAGGED
② KEEP SYSTEM MAXIMUM FEASIBLE DISTANCE FROM WELL
③ SEE ATTACHED SHEETS FOR PUMP & PRESS. MANIFOLD REQUIREMENTS.


Comments/Conditions: ① SEPTIC TANK INSTALLED WITH RISERS & ZABEL FILTER

INITIAL SITE SKETCH

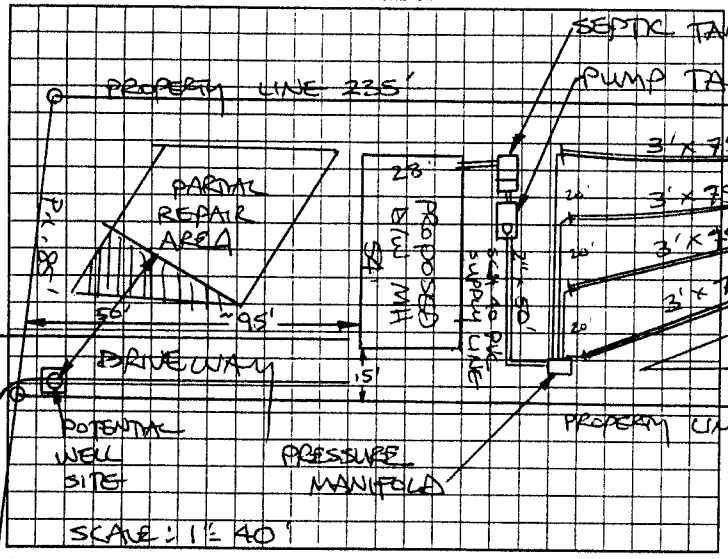

SCALE: 1" = 40'

AS BUILT SKETCH

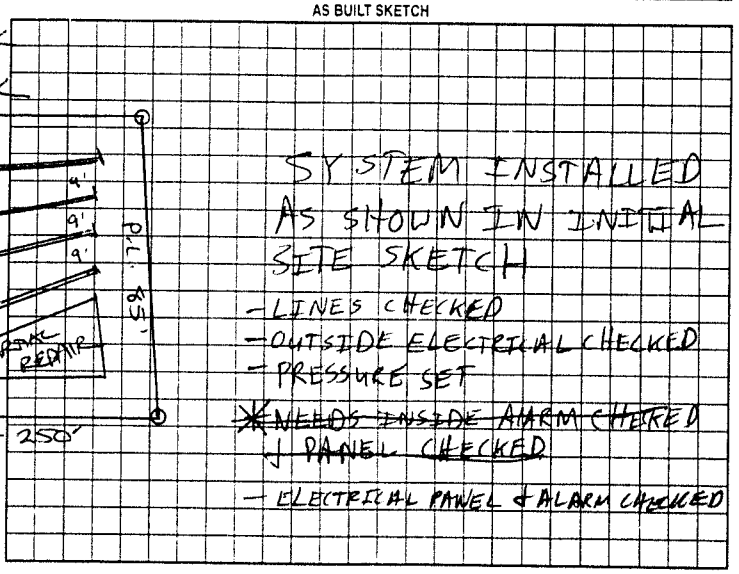

SYSTEM INSTALLED AS SHOWN IN INITIAL SITE SKETCH
- LINES CHECKED
- OUTSIDE ELECTRICAL CHECKED
- PRESSURE SET
- ~~NEEDS INSIDE ALARM CHECKED~~
- PANEL CHECKED
- ELECTRICAL PANEL & ALARM CHECKED

Permit can be suspended or revoked if any false information is supplied toward securing the permit/any unauthorized changes are made to the site/any unauthorized changes are made in the installation of the system. Improvement Permit with plat valid without expiration. Improvement Permit with site plan valid for sixty months. Authorization to Construct is valid for a period equal to that of Improvement Permit – not to exceed sixty months.

Signed [signature] date ____ Installed by: Sherman Dunn

Improvement Permit by: STEVE HEDRICK date 6-26-02 Operation Permit by: [signature] date 08/30/02

Authorization to Construct by: STEVE HEDRICK date 6-26-02 Existing System Inspection by: ____ date ____

HEALTH DEPT. COPY: WHITE OWNER COPY (FINAL): YELLOW OWNER COPY (INITIAL): PINK