4761909673

IREDELL COUNTY HEALTH DEPARTMENT

STATESVILLE 704-878-5305 MOORESVILLE 704-664-5281

IMPROVEMENT PERMIT / CERTIFICATE OF COMPLETION / OPERATION PERMIT / EXISTING SYSTEM INSPECTION

PROPERTY DESCRIPTION NO. 25489 DATE 10/23/96 TAX MAP NO. 4I A 9 PT. Watershed: ☐ Yes ☒ No

OWNER OR CONTRACTOR Samuel Cherry PHONE: Business _____ Home 528-3061

ADDRESS 1511 Shinnville Rd / Cleveland, NC. 27013

LOCATION past Shinns store ~2.5 mile on (L)

SUBDIVISION _____ BLOCK / SECTION _____ LOT _____ LOT AREA _____ SITE CLASS. _____ DESIGN FLOW _____ L.T.A.R. _____

Septic Tank: Existing Gallons ~~Steel~~ Date _____
Pump Tank: _____ Gallons; PT _____ Date _____
Pump Make: _____ Model _____ Serial No. _____
Nitrification Field: No Fields ____ Square Feet _____ Linear Feet _____
No Lines _____ Trench Width _____ Max Trench Bottom Depth _____ Gravel Depth _____

☐ New System ☐ Repair System Type: I, II, III, IV, V, VI
System Description: Existing System
Repair System Description: _____
Maintenance Agreement Required: ☐ Yes ☐ No

☐ House/Mod. Home No. Bedrooms 3
☒ Mobile Home No. Bathrooms 2
☐ Business No. Employees ____
☐ Other _____
☐ Slab ☐ Crawl Space ☐ Basement w/plumbing ☐ Basement wo/plumbing


Water Supply:
☒ Individual
☐ Community
☐ Public

Comments:

Comments:

INITIAL SITE SKETCH

AS BUILT SKETCH

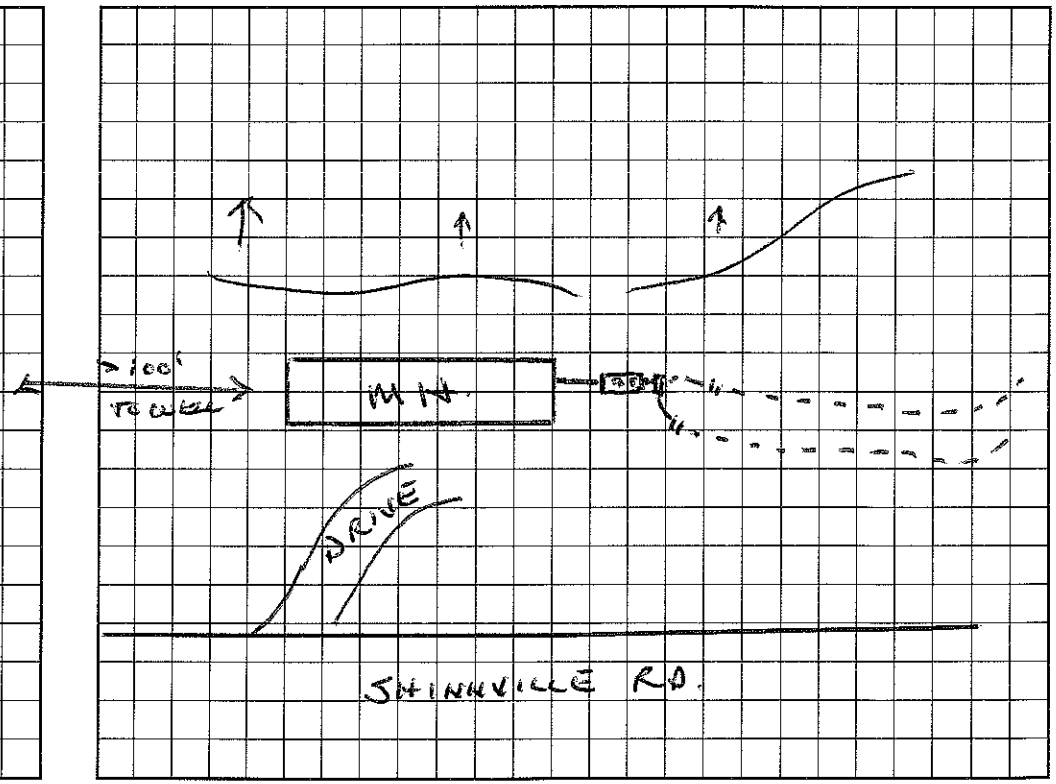

I understand that this permit can be suspended or revoked if any false information is supplied toward securing the permit/any unauthorized changes are made to the site/any unauthorized changes are made in the installation of the system.

Signed: _____

Improvement Permit by: _____ date _____

Existing System Inspection by: _____ date _____

Installed by: _____

Certificate of Completion by: Existing System Wesley Sparks RS. date 10/23/96

Operation Permit by: _____ date _____

HEALTH DEPT. COPY: WHITE INSPECTION COPY (FINAL): GREEN OWNER COPY (FINAL): YELLOW INSPECTION COPY (INITIAL): PINK OWNER COPY (INITIAL): GOLD