IREDELL COUNTY HEALTH DEPARTMENT

STATESVILLE 704-878-5305 MOORESVILLE 704-664-5281

IMPROVEMENT PERMIT / CERTIFICATE OF COMPLETION / OPERATION PERMIT / EXISTING SYSTEM INSPECTION

PROPERTY DESCRIPTION NO. 16474 DATE 6-10-93

OWNER OR CONTRACTOR Charles D. Williams PHONE: Business _____ Home 664-5764 TAX MAP NO. 5F-A-41

ADDRESS Rt 2 Box 260-A Cleveland N.C. 27013

LOCATION 40E TR Triple H Rd TR Hemlock 1mi on left

SUBDIVISION _____ BLOCK / SECTION _____ LOT _____ LOT AREA 2+ acres SITE CLASS. PS. L.T.A.R. .4

Water Supply: ☑ Individual ☐ Community ☐ Public

Septic Tank: 1000 Gallons; STB 359 Date 7-7-93

Pump Tank: — Gallons; PT — Date —

Nitrification Field: No Fields 1 Square Feet 900 Linear Feet 300

No Lines 4 Trench Width 36 Trench Depth 24 Gravel Depth 12

☐ New System ☐ Repair System Type: I. II. III. IV. V. VI

System Description: Conv. Gravity

Repair System Description: _____

Maintenance Agreement Required: ☐ Yes ☑ No

☐ House/Mod. Home ☑ Mobile Home ☐ Business ☐ Other

No. Bedrooms 3 No. Bathrooms 2 No. Employees _____

Garbage Disposal: ☐ Yes ☑ No

Auto. Dishwasher: ☐ Yes ☑ No


Auto. Washing Machine: ☐ Yes ☐ No

Other _____


☐ Slab ☑ Crawl Space ☐ Basement w/plumbing ☐ Basement wo/plumbing

Comments Ex. House burned down Replacing With mobile Home Ex. S.T. system was not functioning properly so replacing with new system

INITIAL SITE SKETCH

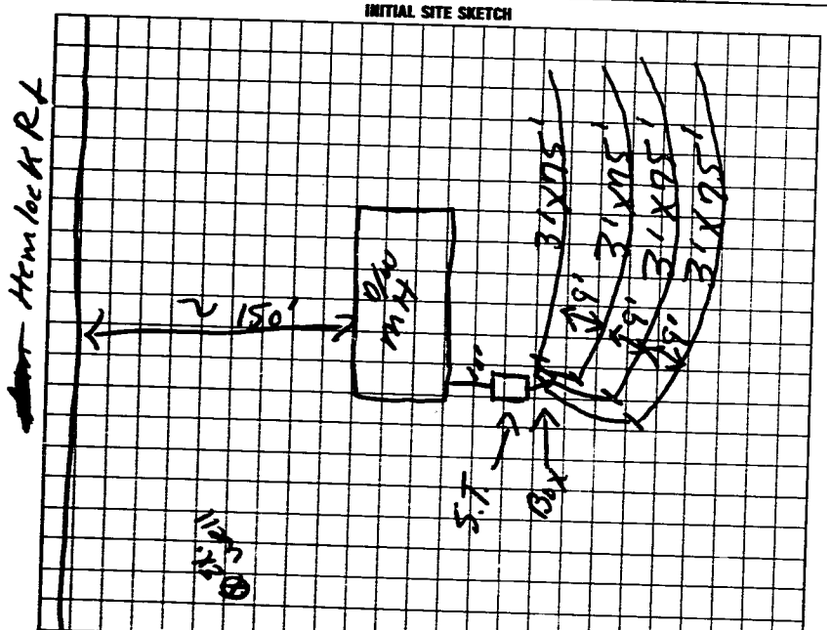

AS BUILT SKETCH

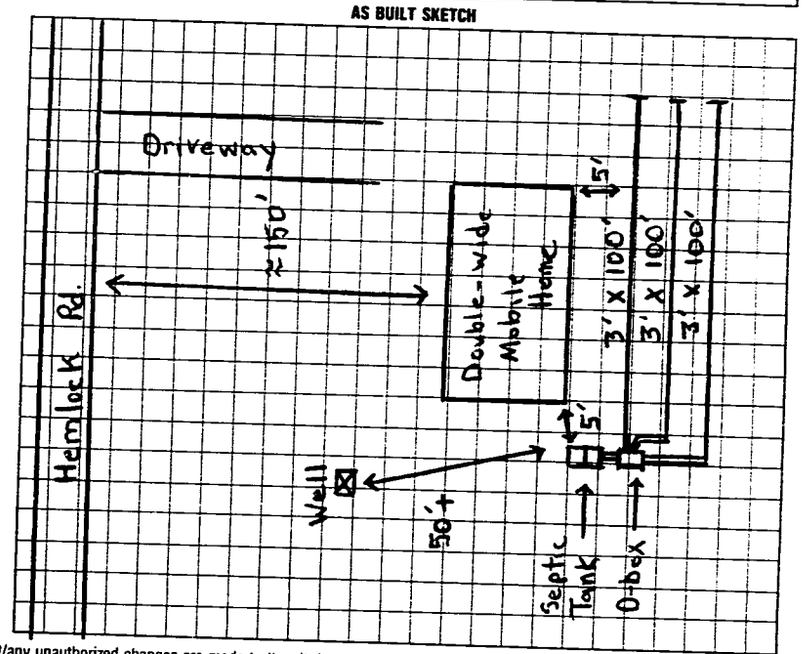

I understand that this permit can be suspended or revoked if any false information is supplied toward securing the permit/any unauthorized changes are made to the site/any unauthorized changes are made in the installation of the system. Improvement Permit is valid for 60 months from date of issuance.

Signed: Charles D. Williams Agent

Improvement Permit by: R.C. moore date 6-10-93

Existing System Inspection by: _____ date _____

Installed by: Ray Beam

Certificate of Completion by: Michael J. Dennis date 8-13-93

Operation Permit by: _____ date _____

HEALTH DEPT. COPY: WHITE INSPECTION COPY (FINAL): GREEN OWNER COPY (FINAL): YELLOW INSPECTION COPY (INITIAL): PINK OWNER COPY (INITIAL): GOLD