REDELL COUNTY HEALTH DEPARTMENT

STATESVILLE 704-878-5305 MOORESVILLE 704-664-5281

IMPROVEMENT PERMIT / AUTHORIZATION TO CONSTRUCT / OPERATION PERMIT / EXISTING SYSTEM INSPECTION

PERMIT # 35092 PIN # 4761971765 DATE 4-15-09

OWNER or APPLICANT Annie Lackey PHONE: Business Home: 704-253 ~~5183~~ 5138

OWNER or APPLICANT ADDRESS 912 Wilson Lee BLVD Statesville NC 28677

LOCATION / DIRECTIONS Triplett RD (TR) Hemlock (TR) Blue spruce

SUBDIVISION BLOCK / SECTION LOT # LOT AREA .5 DESIGN FLOW 240 L.T.A.R. Exist

Septic Tank Exist Gallons: STB Exist Date Exist

Pump Tank Gallons: P T Date

Pump Make Model Serial #

Nitrification Field No Fields No Lines 2 Linear Feet 200

Trench Width Exist (36) Max. Trench Bottom Depth Exist Gravel Depth

~~New System~~ ☐ Repair ☐ Expansion System Type I II III IV V VI

System Description: Gravel Conventional

Repair System Description: Gravel Conventional

Maintenance Agreement Required ☐ YES ☐ NO

☑ GRAVITY ☐ PRESSURE

☑ Residence No. Bedrooms 2

☐ Business No. Persons

☐ Other No. Employees

☐ Slab ☐ Crawl Space


☐ Basement w/plumbing ☐ Basement w/o plumbing

Water Supply: ☑ Private ☐ Public ☐ Community


Comments / Conditions

Comments / Conditions

INITIAL SITE SKETCH

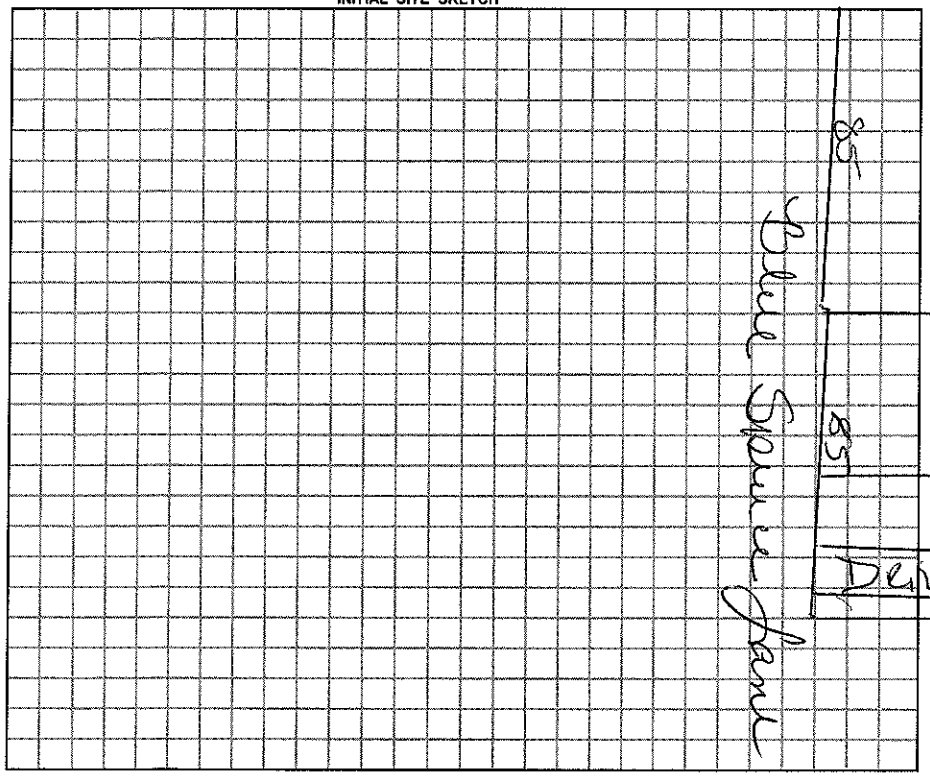

AS BUILT SKETCH

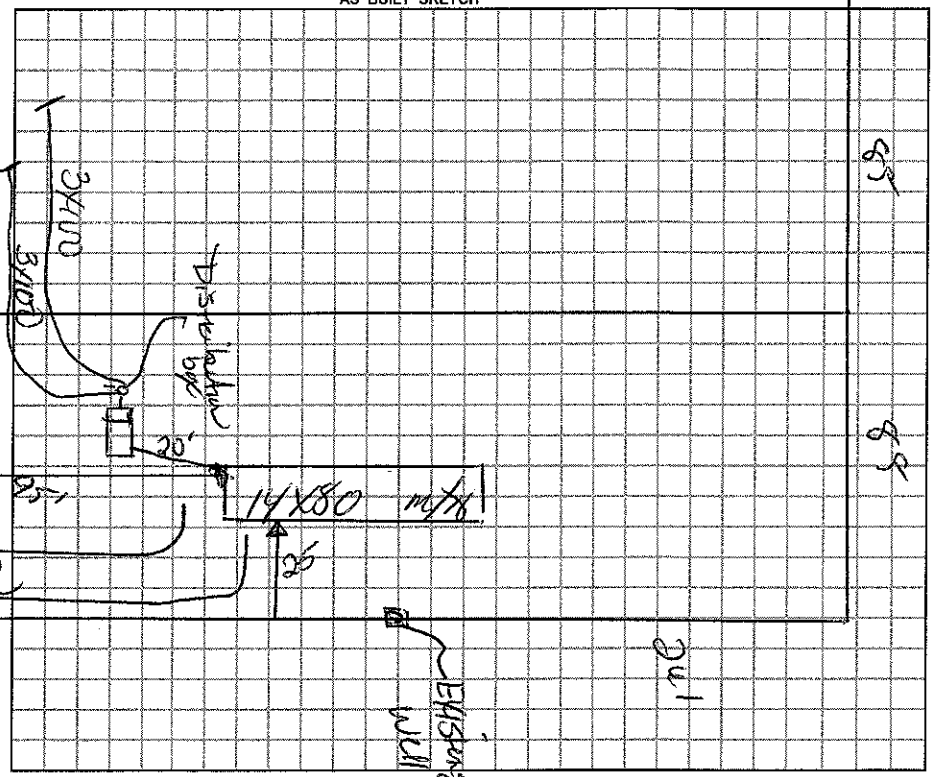

Permit can be suspended or revoked if any false information is supplied toward securing the permit / any unauthorized changes are made to the site / any unauthorized changes are made in the installation of the system.

☐ *IMPROVEMENT PERMIT w / plat valid without expiration.* ☐ *IMPROVEMENT PERMIT w / site plan valid for 60 mos.* ☑ *AUTHORIZATION TO CONSTRUCT valid for period equal to IMPROVEMENT PERMIT-not to exceed 60 mo.*

Owner / Applicant Signature: Annie Lackey Date 4-15-09

Improvement Permit by: Date

Authorization to Construct by: Date

Installed by:

Operation Permit by: Date:

Existing System Inspected by: Date: 4-15-09

YOU SHOULD CONTACT A LOCATOR SERVICE PRIOR TO ANY EXCAVATION.

WHITE COPY Environmental Health YELLOW COPY (Final) Owner / Applicant PINK COPY (Initial) Owner / Applicant