Addition / Upgrade

IREDELL COUNTY HEALTH DEPARTMENT

STATESVILLE 704-878-5305 MOORESVILLE 704-664-5281

IMPROVEMENT PERMIT / AUTHORIZATION TO CONSTRUCT / OPERATION PERMIT / EXISTING SYSTEM INSPECTION

PERMIT# 100493 PIN# 4761972415 DATE 8-3-2001

OWNER OR CONTRACTOR Clayton Homes (Alvin Clement) PHONE: Business Ray Benge 873-2547 Home

ADDRESS 125 Blue Spruce Ln Cleveland, NC 27013

LOCATION Amity Oswalt Rd TL Hemlock Drive to left Blue Spruce Ln.

SUBDIVISION BLOCK / SECTION LOT LOT AREA SITE CLASS PS DESIGN FLOW 480gpd L.T.A.R. .3+

Septic Tank: 1000 Gallons: STB Date

Pump Tank: Gallons: PT Date

Pump Make: Model Adding Serial No.

Nitrification Field: No Fields Total=2 Square Feet 1,300' Linear Feet 100'

No Lines 1 Trench Width 36" Max Trench Bottom Depth 36" Gravel Depth 12"

☐ New System ☐ Repair System Type: I II III IV V VI

System Description: Addition Gravity-Conventional

Repair System Description: Gravity-Conventional

Maintenance Agreement Required: ☐ Yes ☒ No

☐ House/Mod. Home ☒ Mobile Home ☐ Business ☐ Other

No. Bedrooms 4 No. Bathrooms 2 No. Employees

☐ Slab ☒ Crawl Space ☐ Basement w/plumbing ☐ Basement wo/plumbing


Water Supply: ☒ Individual ☐ Public ☐ Community

Comments/Conditions: Add 1 line 3'x100' line to lower drainfield add drop box to line above. Use "bull run" valve & alternate between fields. Use original field during hot dry months.

Comments/Conditions: Bull run valve makes system Type 3

INITIAL SITE SKETCH

Not to Scale

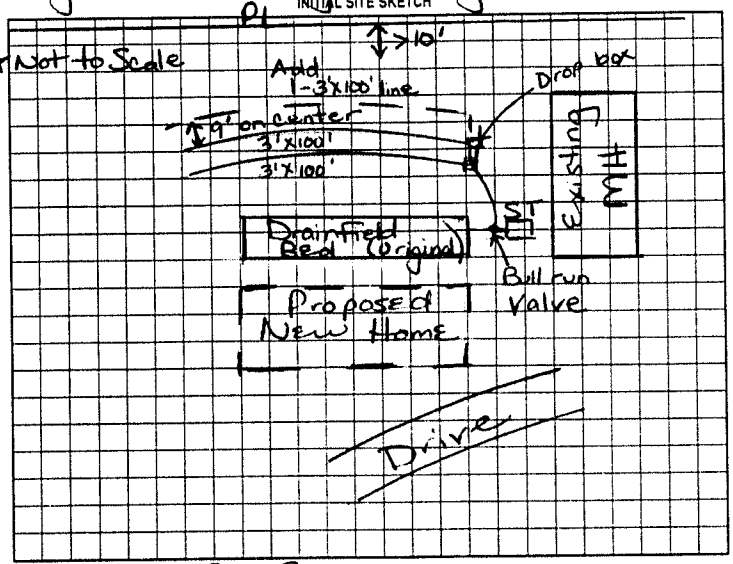

AS BUILT SKETCH

SYSTEM EXPANDED ACCORDING TO INITIAL SITE SKETCH

Permit can be suspended or revoked if any false information is supplied toward securing the permit/any unauthorized changes are made to the site/any unauthorized changes are made in the installation of the system. Improvement Permit with plat valid without expiration. Improvement Permit with site plan valid for sixty months. Authorization to Construct is valid for a period equal to that of Improvement Permit – not to exceed sixty months.

Signed: Ray Benge date 8-9-01

Improvement Permit by: Maria H. Dotson RS date 8/6/2001

Authorization to Construct by: (System Upgrade) Maria H. Dotson RS date 8/6/2001

Installed by: A-1 BACKHOE

Operation Permit by: STEVE HERRICK date 8.21-01

Existing System Inspection by: date

HEALTH DEPT COPY WHITE OWNER COPY (FINAL) YELLOW OWNER COPY (INITIAL) PINK