64828

IREDELL COUNTY HEALTH DEPARTMENT

STATESVILLE 704-878-5305 MOORESVILLE 704-664-5281

IMPROVEMENT PERMIT / CERTIFICATE OF COMPLETION / OPERATION PERMIT / EXISTING SYSTEM INSPECTION

PROPERTY DESCRIPTION NO. 25552 DATE 1- -97 TAX MAP NO. SF-H-47 Watershed: ☐ Yes ☒ No

OWNER OR CONTRACTOR Stephanie B Bowman PHONE: Business Home 871-8661

ADDRESS 103 Redwood Ln Statesville NC

LOCATION 215 TL Oswalt Amity Hill Rd TL Hemlock TL Blue Spruce 1st on Right

SUBDIVISION BLOCK / SECTION LOT LOT AREA 0.73 ac. SITE CLASS. P/S DESIGN FLOW 360 L.T.A.R. 0.3

Septic Tank: Existing Gallons: STB Date

Pump Tank: Gallons: PT Date

Pump Make: Model Serial No.

Nitrification Field: No Fields 1 Square Feet 1200 Linear Feet 400

No Lines 4 Trench Width 36 Max Trench Bottom Depth 36 Gravel Depth 12

☒ New System ☐ Repair System Type: I, II, III, IV, V, VI

System Description: Conventional Gravity

Repair System Description: Conventional Gravity

Maintenance Agreement Required: ☐ Yes ☒ No

☐ House/Mod. Home ☒ Mobile Home ☐ Business ☐ Other

No. Bedrooms 3 No. Bathrooms 2 No. Employees


☐ Slab ☒ Crawl Space ☐ Basement w/plumbing ☐ Basement wo/plumbing

Water Supply: ☒ Individual ☐ Community ☐ Public


Comments: keep lines on contour, 9ft on center
System is located in Easement Area
Repair in Easement Area

Comments:
* Need to Landscape & seed
or hydroseed

INITIAL SITE SKETCH

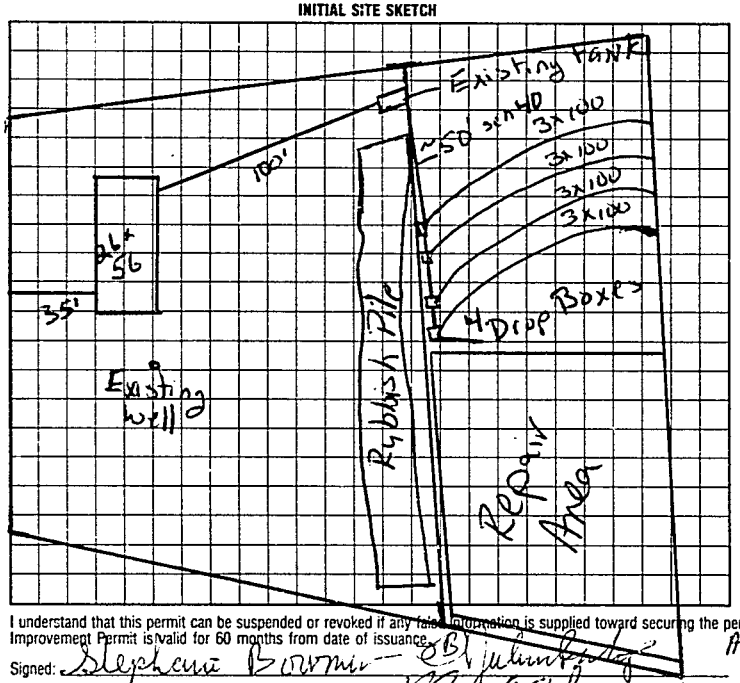

AS BUILT SKETCH

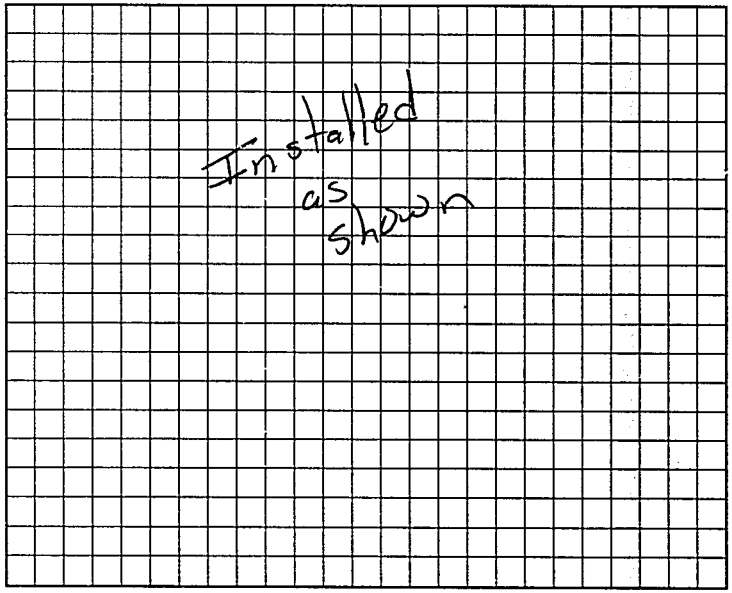

I understand that this permit can be suspended or revoked if any false information is supplied toward securing the permit/any unauthorized changes are made to the site/any unauthorized changes are made in the installation of the system. Improvement Permit is valid for 60 months from date of issuance.

Signed: Stephanie Bowman - SB by Julian Phillips

Improvement Permit by: 4 Mo C Op date

Existing System Inspection by: Authorization to Const. 4 Mo C Op date

Authorization to Const. expires 5 yrs from issue date

Installed by: George Miller

Certificate of Completion by: date

Operation Permit by: 4 Mo C Op RS date 1-21-97

HEALTH DEPT. COPY: WHITE INSPECTION COPY (FINAL): GREEN OWNER COPY (FINAL): YELLOW INSPECTION COPY (INITIAL): PINK OWNER COPY (INITIAL): GOLD

E 6 5 2 0 0