CI

IREDELL COUNTY HEALTH DEPARTMENT

STATESVILLE 704-878-5305 MOORESVILLE 704-664-5281

IMPROVEMENT PERMIT / AUTHORIZATION TO CONSTRUCT / OPERATION PERMIT / EXISTING SYSTEM INSPECTION

PERMIT# 13599 PIN# 4761 97 7402 6720 DATE 6-21-06

OWNER OR APPLICANT SCOTT WESTMORELAND PHONE: Business 704-819-6415 Home

ADDRESS 1350 MCLEOD RD HUNTERSVILLE NC 28078

LOCATION 7750 FT @ AMITY HILL @ SWANANOA @ HOMELAND @ GENESIS ON LEFT IMMEDIATELY PAST HOMELAND

SUBDIVISION WESTMORELAND ESTATES BLOCK / SECTION LOT 4 LOT AREA 1.374 AC SITE CLASS. PS DESIGN FLOW 240 L.T.A.R. 13

Septic Tank: 1000 Gallons; STB 1017 Date 1-20-06
Pump Tank: Gallons; PT Date
Pump Make: Model Serial No.
Nitrification Field: No Fields 1 Square Feet EQ=800' Linear Feet 200'
No Lines 3 Trench Width 36" Max Trench Bottom Depth 21"

☒ New System ☐ Repair ☐ Expansion System Type: I (II) III IV V VI
System Description: GRAVITY 35% LPP 35% REDUCTION
Repair System Description:
Maintenance Agreement Required: ☐ Yes ☒ No


☐ House/Mod. Home ☒ Mobile Home ☐ Business ☐ Other
No. Bedrooms 2 No. Persons 4 No. Employees

Water Supply: ☒ Individual ☐ Public ☐ Community


Gravel Depth N/A ☒ Gravity ☐ Pressure ☐ Slab ☒ Crawl Space ☐ Basement w/plumbing ☐ Basement wo/plumbing

Comments:/Conditions: (1) MAINTAIN SETBACK WITH POSITIVE DRAINAGE. EXIT SURFACE WATER TOWARDS E/W OF GENESIS (2) NOTE MAXIMUM TRENCH BOTTOM DEPTH OF 21" (3) HOUSE AND SYSTEM IS FURNISHED TUFF LITE FILTER SYSTEM

INITIAL SITE SKETCH "NOT TO SCALE"

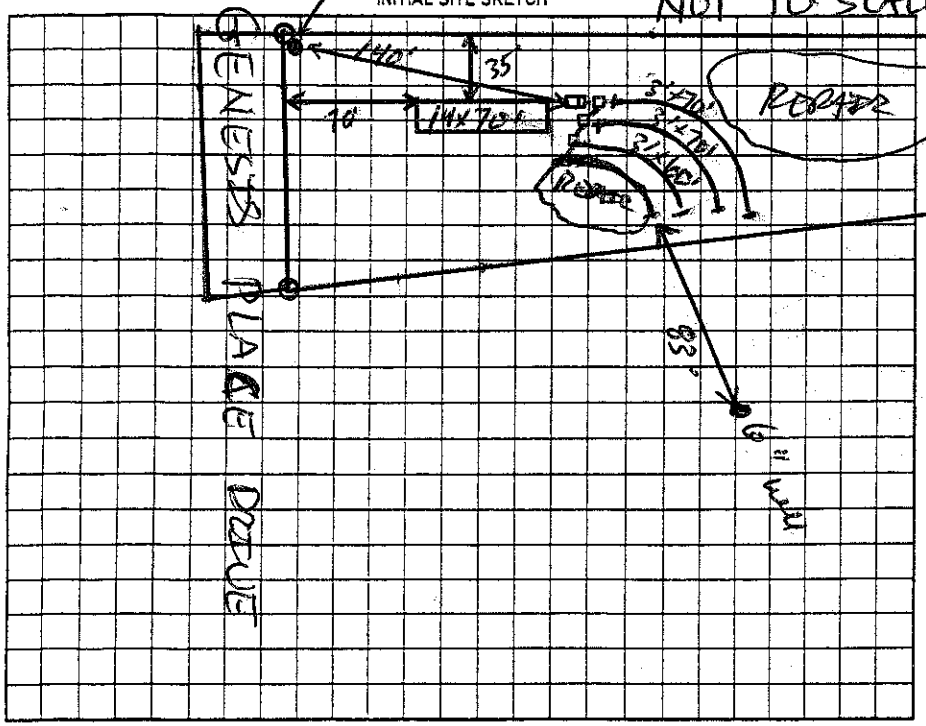

AS BUILT SKETCH

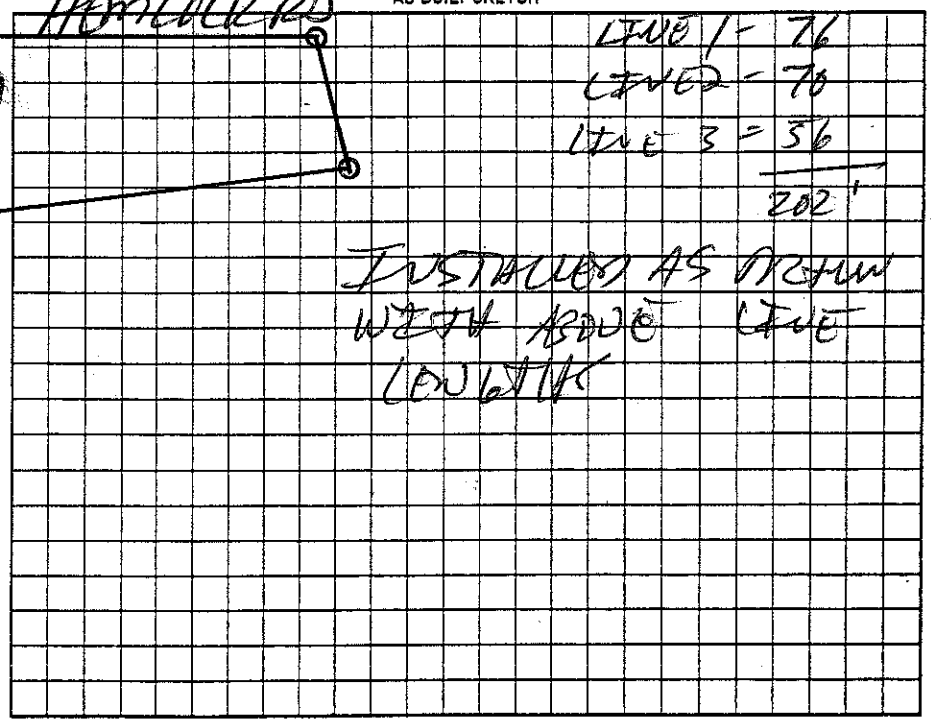

Permit can be suspended or revoked if any false information is supplied toward securing the permit/any unauthorized changes are made to the site/any unauthorized changes are made in the installation of the system. Improvement Permit with plat valid without expiration ☐ Improvement Permit with site plan valid for sixty months ☒ Authorization to Construct is valid for a period equal to that of Improvement Permit – not to exceed sixty months.

Signed: Scott Westmoreland date 6-22-06 Installed by: T. Ireland

Improvement Permit by: date 6-21-06 Operation Permit by: date 7-13-06

Authorization to Construct by: date 6-21-06 Existing System Inspection by: date

HEALTH DEPT. COPY: WHITE OWNER COPY (FINAL): YELLOW OWNER COPY (INITIAL): PINK

1-20-06 2750 5.00 3150 NV SEPTIC @ 417 EXIT 45 FOUNDATION