IREDELL COUNTY HEALTH DEPARTMENT

STATESVILLE 704-878-5305 (CI) MOORESVILLE 704-664-5281

IMPROVEMENT PERMIT / AUTHORIZATION TO CONSTRUCT / OPERATION PERMIT / EXISTING SYSTEM INSPECTION

(O)

PERMIT# 142590 PIN# 4761-97-7916 DATE 5-29-07

OWNER OR APPLICANT JENNIFER M. WESTMORELAND PHONE: Business _____ Home 704-819-6415

ADDRESS 13501 McCORD ROAD, HUNTERSVILLE NC 28078

LOCATION US 21 SOUTH TL O'STUART AMITY RD TL HEMLOCK ROAD, TL GENESIS PL, 1ST ON RIGHT

SUBDIVISION Westmoreland BLOCK/SECTION _____ LOT 3 LOT AREA 0.99 ACRES SITE CLASS. PS DESIGN FLOW 240 L.T.A.R. 6.25 GPD/FT

Septic Tank: 1000 Gallons: STB 1007 Date 7-14-08

Pump Tank: _____ Gallons: PT _____ Date _____

Pump Make: _____ Model EQ-28 Serial No. _____

Nitrification Field: No Fields 1 Square Feet 960 Linear Feet 240

No Lines THREE Trench Width 36" Max Trench Bottom Depth 24"

☐ New System ☐ Repair ☐ Expansion System Type: I II III IV V VI

System Description: 25% REDUCTION, GRAVITY

Repair System Description: 25% REDUCTION, GRAVITY

Maintenance Agreement Required: ☐ Yes ☒ No

Gravel Depth N/A ☐ Gravity ☐ Pressure

☐ House/Mod. Home ☒ Mobile Home ☐ Business ☐ Other

No. Bedrooms 2 No. Persons ____ No. Employees ____


Water Supply: ~~Individual~~ ☐ Public ☐ Community WELL

☐ Slab ☒ Crawl Space ☐ Basement w/plumbing ☐ Basement wo/plumbing


Comments:/Conditions: ① KEEP SYSTEM MAXIMUM FEASIBLE DISTANCE (~70') FROM WELL. ② INSTALL 25% REDUCTION SYSTEM ON CONTOUR, NO DEEPER THAN 24"

Comments:/Conditions: SEPTIC TANK WITH MARKER INSTALLED USING "BOWLO" FILTER

INITIAL SITE SKETCH ~SCALE: 1"=40'

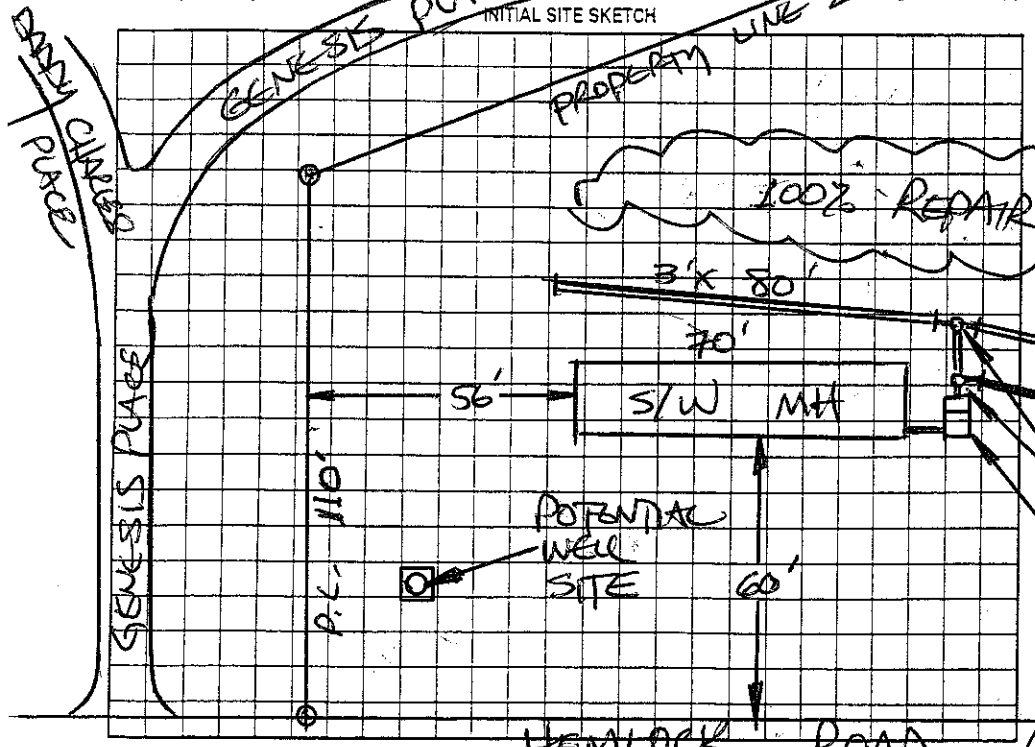

AS BUILT SKETCH

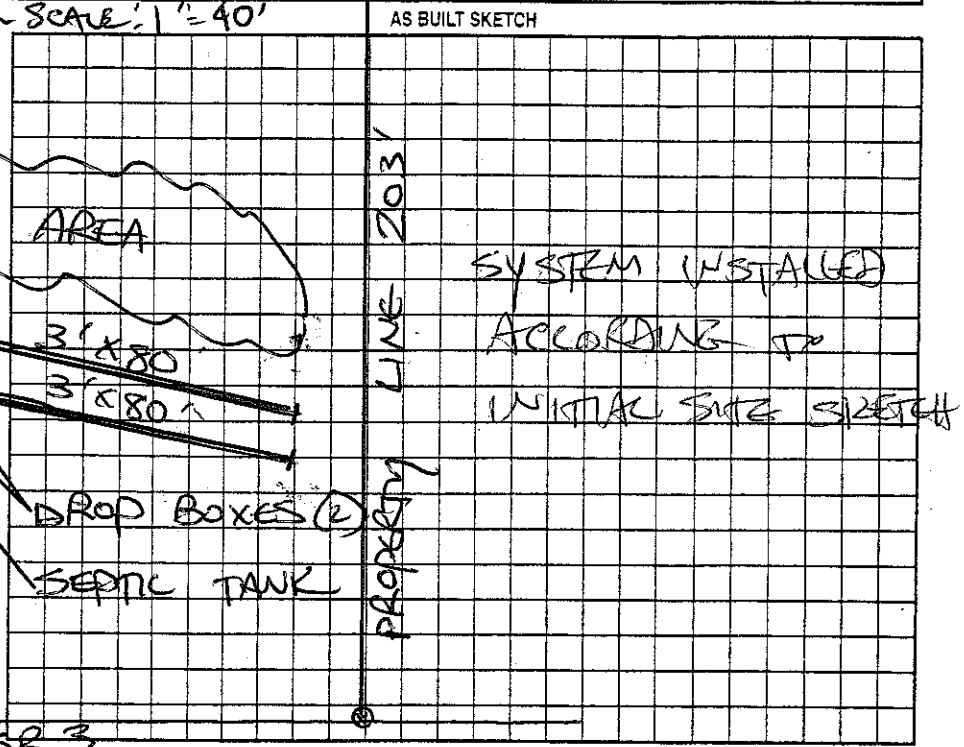

Permit can be suspended or revoked if any false information is supplied toward securing the permit/any unauthorized changes are made to the site/any unauthorized changes are made in the installation of the system. Improvement Permit with plat valid without expiration ☐ Improvement Permit with site plan valid for sixty months ☒ Authorization to Construct is valid for a period equal to that of Improvement Permit – not to exceed sixty months.

Signed: T Scott Westmoreland date 5-29-07 Installed by: CHARLES BEATTY

Improvement Permit by: STEVE HEDRICK date 5-29-07 Operation Permit by: STEVE HEDRICK date 10-6-2008

Authorization to Construct by: STEVE HEDRICK date 5-29-07 Existing System Inspection by: _____ date _____

HEALTH DEPT. COPY: WHITE OWNER COPY (FINAL): YELLOW OWNER COPY (INITIAL): PINK