IREDELL COUNTY HEALTH DEPARTMENT

STATESVILLE 704-878-5305 MOORESVILLE 704-664-5281

IMPROVEMENT PERMIT / AUTHORIZATION TO CONSTRUCT / OPERATION PERMIT / EXISTING SYSTEM INSPECTION

PERMIT# 87428 PIN# 4761 98 1445 PT DATE 1-25-00

OWNER OR CONTRACTOR C.D. Heaggans Jr. PHONE: Business _____ Home 871-9838

ADDRESS 146 Yellowstone Ln. Statesville N.C.

LOCATION 70E TR Bethesda TL Oswalt-Amity TL Hemlock TL Blue Spruce TL Private Dr.

SUBDIVISION Heggens Property BLOCK / SECTION _____ LOT 3 LOT AREA 1.0 acres SITE CLASS PS DESIGN FLOW 360 L.T.A. (.3) 118 m

Septic Tank: 1000 Gallons; STB 1794 Date 11-22-99

Pump Tank: _____ Gallons; PT _____ Date _____

Pump Make: _____ Model _____ Serial No. _____

Nitrification Field: No. Fields 1 Square Feet 1200 Linear Feet 400

No. Lines 4 Trench Width 36" Max Trench Bottom Depth 36" Gravel Depth 12"

☐ New System ☐ Repair System Type: I II III IV V VI

System Description: Conv. Gravity

Repair System Description: " "

Maintenance Agreement Required: ☐ Yes ☒ No

☐ House/Mod. Home No. Bedrooms 3

☒ Mobile Home No. Bathrooms 2

☐ Business No. Employees _____

☐ Other _____


☐ Slab ☒ Crawl Space ☐ Basement w/plumbing ☐ Basement wo/plumbing

Water Supply: ☒ Individual ☐ Public ☐ Community


Comments/Conditions:

Comments /Conditions:

INITIAL SITE SKETCH 194'

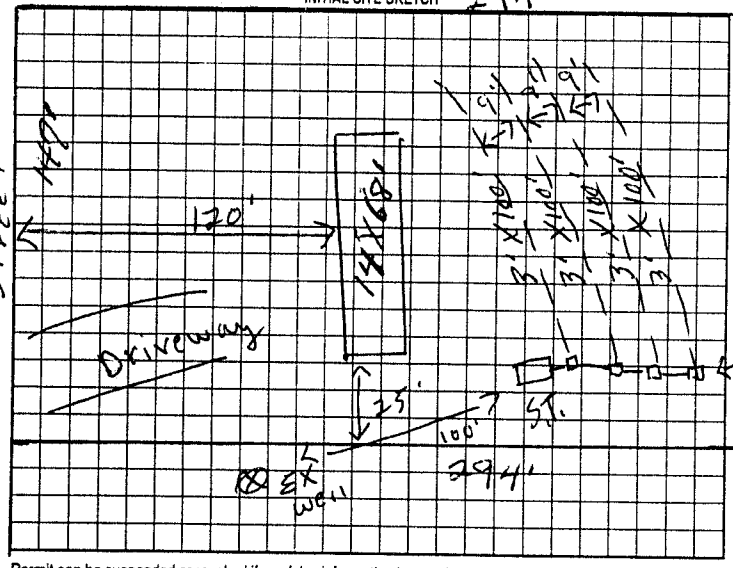

AS BUILT SKETCH

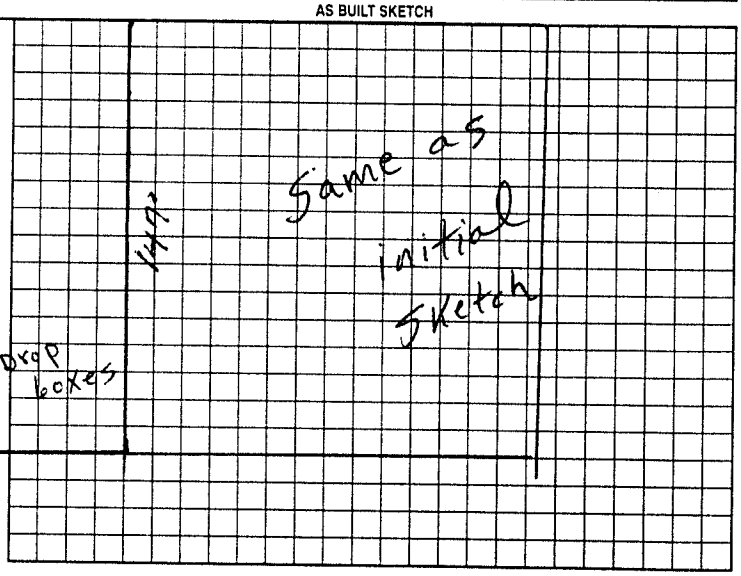

Permit can be suspended or revoked if any false information is supplied toward securing the permit/any unauthorized changes are made to the site/any unauthorized changes are made in the installation of the system. Improvement Permit with plat valid without expiration. Improvement Permit with site plan valid for sixty months. Authorization to Construct is valid for a period equal to that of Improvement Permit – not to exceed sixty months.

Signed: _____ date 1-25-00 Installed by: Keany Madison

Improvement Permit by: R. C. Moore date 1-25-00 Operation Permit by: R. C. Moore date 2-25-00

Authorization to Construct by: R. C. Moore date 1-25-00 Existing System Inspection by: _____ date _____

HEALTH DEPT. COPY: WHITE OWNER COPY (FINAL): YELLOW OWNER COPY (INITIAL): PINK