IREDELL COUNTY HEALTH DEPARTMENT

STATESVILLE 704-878-5305 MOORESVILLE 704-664-5281

IMPROVEMENT PERMIT / AUTHORIZATION TO CONSTRUCT / OPERATION PERMIT / EXISTING SYSTEM INSPECTION

PERMIT# 20811 PIN# 4761 98 4445 DATE 5-17-99

OWNER OR CONTRACTOR Robert Rickney PHONE: Business 528 5028 Home

ADDRESS 893 ~~Oswalt~~ / ~~Hwy~~ Bethesda Rd Statesville

LOCATION Oswalt Amity TL Hemlock 1 mi TL New Street 1/2 mi L

SUBDIVISION Heaggin Prop. BLOCK / SECTION LOT 2 LOT AREA 1.3 acres SITE CLASS PS DESIGN FLOW ~~440~~ 480 L.T.A.R. .33

Septic Tank: 1000 Gallons: STB 825 Date 4/22/00
Pump Tank: Gallons; PT Date
Pump Make: Model Serial No.
Nitrification Field: No Fields 1 Square Feet 1440 Linear Feet 480
No Lines 4 Trench Width 36" Max Trench Bottom Depth 36" Gravel Depth 12"

☑ New System ☐ Repair System Type: I, II, III, IV, V, VI
System Description: Conv. Gravity
Repair System Description:
Maintenance Agreement Required: ☐ Yes ☑ No
☐ Slab ☑ Crawl Space ☐ Basement w/plumbing ☐ Basement wo/plumbing


☐ House/Mod. Home No. Bedrooms 4
☑ Mobile Home No. Bathrooms 2
☐ Business No. Employees
☐ Other

Water Supply: ☑ Individual ☐ Public ☐ Community


Comments/Conditions:

Comments/Conditions:

INITIAL SITE SKETCH

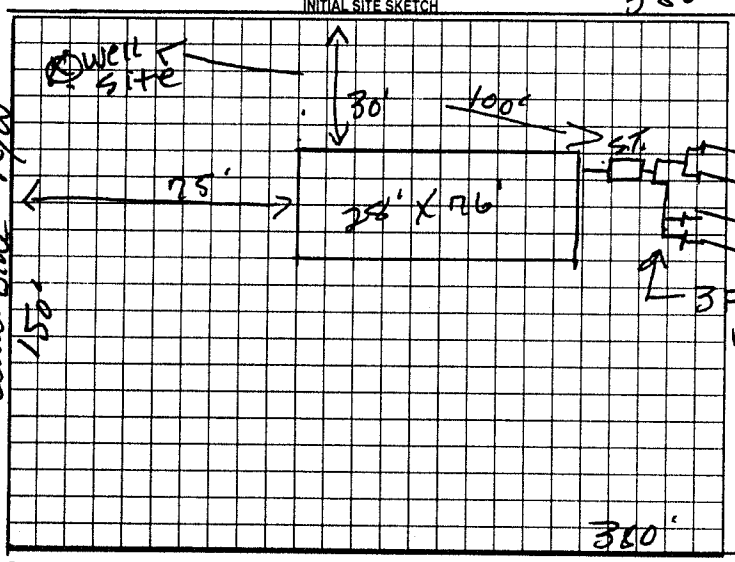

AS BUILT SKETCH

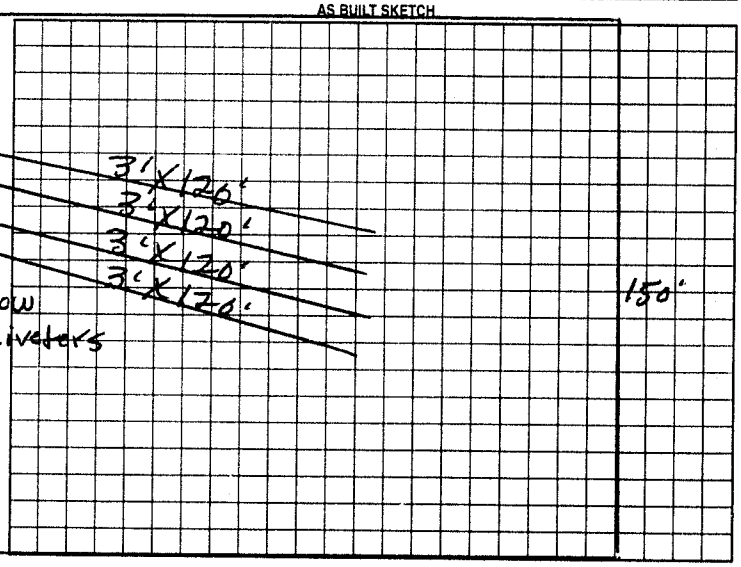

Permit can be suspended or revoked if any false information is supplied toward securing the permit/any unauthorized changes are made to the site/any unauthorized changes are made in the installation of the system. Improvement Permit with plat valid without expiration. Improvement Permit with site plan valid for sixty months. Authorization to Construct is valid for a period equal to that of Improvement Permit – not to exceed sixty months.

Signed: X Robert D. Pinkney date Installed by: AG Houston

Improvement Permit by: C. C. Moore date 5-17-99 Operation Permit by: Gig Mulf RS date 8/11/00

Authorization to Construct by: C. C. Moore date 5-17-99 Existing System Inspection by: date

HEALTH DEPT. COPY: WHITE OWNER COPY (FINAL): YELLOW OWNER COPY (INITIAL): PINK