IREDELL COUNTY HEALTH DEPARTMENT

STATESVILLE 704-878-5305 (C1) MOORESVILLE 704-664-5281

IMPROVEMENT PERMIT / AUTHORIZATION TO CONSTRUCT / OPERATION PERMIT / EXISTING SYSTEM INSPECTION

PERMIT# 108719 PIN# ~~4761-99-9032.13~~ 4761-98-8541 DATE 10-14-02

OWNER OR CONTRACTOR TERESA NEWTON PHONE Business (704) 363-6964 Home

ADDRESS 525 SHEPHERD RD, TROUTMAN, NC 28166

LOCATION US 70 EAST, TR TRIPLETT ROAD, TR HEMLOCK ROAD, 0.7 MILE ON RIGHT

SUBDIVISION WILLIAM C. SUMNER BLOCK / SECTION LOT 13 LOT AREA 0.853 ACRE SITE CLASS PS DESIGN FLOW 480 L.T.A.R. 0.30 GPD/FT²

Septic Tank: 1000 Gallons; STB 821 Date 10-8-02
Pump Tank: Gallons; PT Date
Pump Make: Model Serial No
Nitrification Field: No Fields 1 Square Feet 1600 Linear Feet 400
No Lines FIVE Trench Width 36" Max Trench Bottom Depth 36" Gravel Depth N/A

☑ New System ☐ Repair System Type: I II (III) IV V VI
System Description: 25% REDUCTION, GRAVITY
Repair System Description: 50% REDUCTION, GRAVITY
Maintenance Agreement Required: ☐ Yes ☑ No
☐ Slab ☑ Crawl Space ☐ Basement w/plumbing ☐ Basement wo/plumbing


☑ House/Mod. Home No. Bedrooms 4
☐ Mobile Home No. Bathrooms 2
☐ Business No. Employees
☐ Other

Water Supply: ☑ Individual ☐ Public ☐ Community WELL


Comments/Conditions: ① KEEP SYSTEM MAXIMUM FEASIBLE DISTANCE FROM WELL (80') ② INSTALL LINES AS FLAGGED ON SLOPES LESS THAN 25%, 15A NCAC 18A .1955 (8) USING 25% REDUCTION SYSTEM

Comments/Conditions: SEPTIC TANK WITH MARKER INSTALLED USING "SIMTECH" FILTER

INITIAL SITE SKETCH

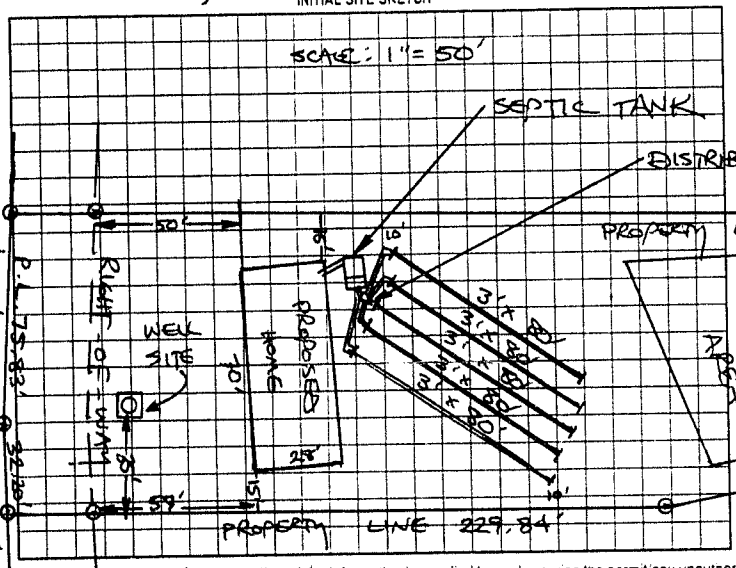

AS BUILT SKETCH

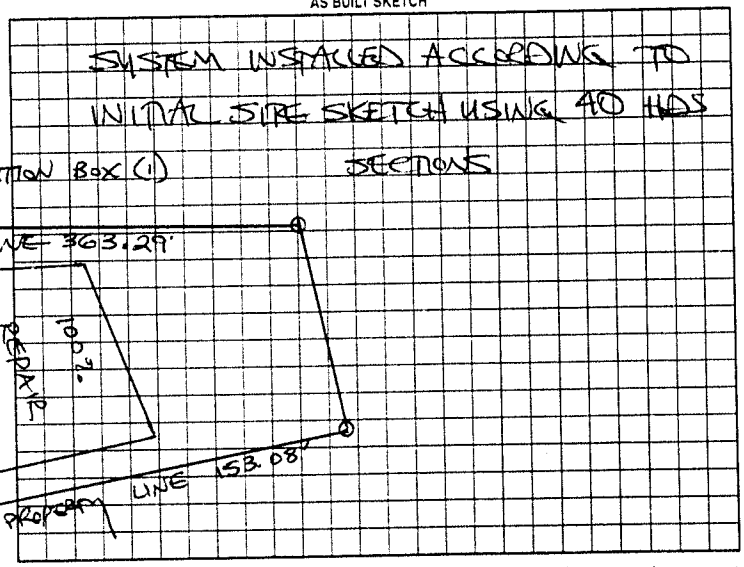

Permit can be suspended or revoked if any false information is supplied toward securing the permit, any unauthorized changes are made to the site, any unauthorized changes are made in the installation of the system. Improvement Permit with plat valid without expiration. Improvement Permit with site plan valid for sixty months. Authorization to Construct is valid for a period equal to that of Improvement Permit - not to exceed sixty months.

Signed: [signature] date

Improvement Permit by: STEVE HEDRICK date 10-14-02

Authorization to Construct by: STEVE HEDRICK date 10-14-02

Installed by: CHERRYVILLE GRADING

Operation Permit by: STEVE HEDRICK date 11-22-02

Existing System Inspection by: date

HEALTH DEPT COPY WHITE OWNER COPY (FINAL) YELLOW OWNER COPY (INITIAL) PINK