HEMLOCK HAVEN

IREDELL COUNTY HEALTH DEPARTMENT

THIS PERMIT VOIDS PREVIOUS ISSUED 10-14-02

STATESVILLE 704-878-5305 MOORESVILLE 704-664-5281

IMPROVEMENT PERMIT / AUTHORIZATION TO CONSTRUCT / OPERATION PERMIT / EXISTING SYSTEM INSPECTION

PERMIT# 108718 PIN# 4761-98-8652.8612 DATE 1-17-03

OWNER OR CONTRACTOR TERESA NEWTON PHONE: Business (704) 363-6964 Home (704) 528-7120

ADDRESS 525 SHEPHERD ROAD, TROUTMAN, NC 28166

LOCATION US 70 EAST, TR TRIPLETT ROAD, TR HEMLOCK ROAD, 0.7 MILE ON RIGHT

SUBDIVISION ~~WILLIAM C. SWART~~ BLOCK / SECTION _____ LOT 12 LOT AREA 0.957 ACRE SITE CLASS. PS DESIGN FLOW 480 L.T.A.R. 0.25 GPD/FT²

Septic Tank: 1000 Gallons; STB 1012 Date 05/02/02

Pump Tank: _____ Gallons; PT _____ Date _____

Pump Make: _____ Model _____ Serial No. _____

Nitrification Field: No Fields 1 Square Feet Eq. To 1920 Linear Feet 480

No Lines SEVEN Trench Width 36" Max Trench Bottom Depth 36" Gravel Depth N/A

☑ New System ☐ Repair System Type: I, II, III, IV, V, VI

System Description: 25% REDUCTION, GRAVITY

Repair System Description: 50% REDUCTION, PUMP

Maintenance Agreement Required: ☐ Yes ☑ No

☑ House/Mod. Home ☐ Mobile Home ☐ Business ☐ Other

No. Bedrooms 4 No. Bathrooms 2 No. Employees _____

☐ Slab ☑ Crawl Space ☐ Basement w/plumbing ☐ Basement wo/plumbing


Water Supply: ☑ Individual ☐ Public ☐ Community WELL

Comments/Conditions: ① USE ONE FLOW DIVIDER TEE TO ACHIEVE EQUAL DISTRIBUTION INTO TWO DISTRIBUTION BOXES FEEDING 240 FEET OF 25% REDUCTION LINE EACH. ② KEEP SYSTEM MAX. FEASIBLE DISTANCE FROM WELL (85')


Comments/Conditions: - SEPTIC TANK INSTALLED USING TUFF-TIGHT FILTER & TANK MARKER.

* SYSTEM INSTALLED DURING WET SOIL CONDITIONS.

INITIAL SITE SKETCH SCALE: 1"=50'

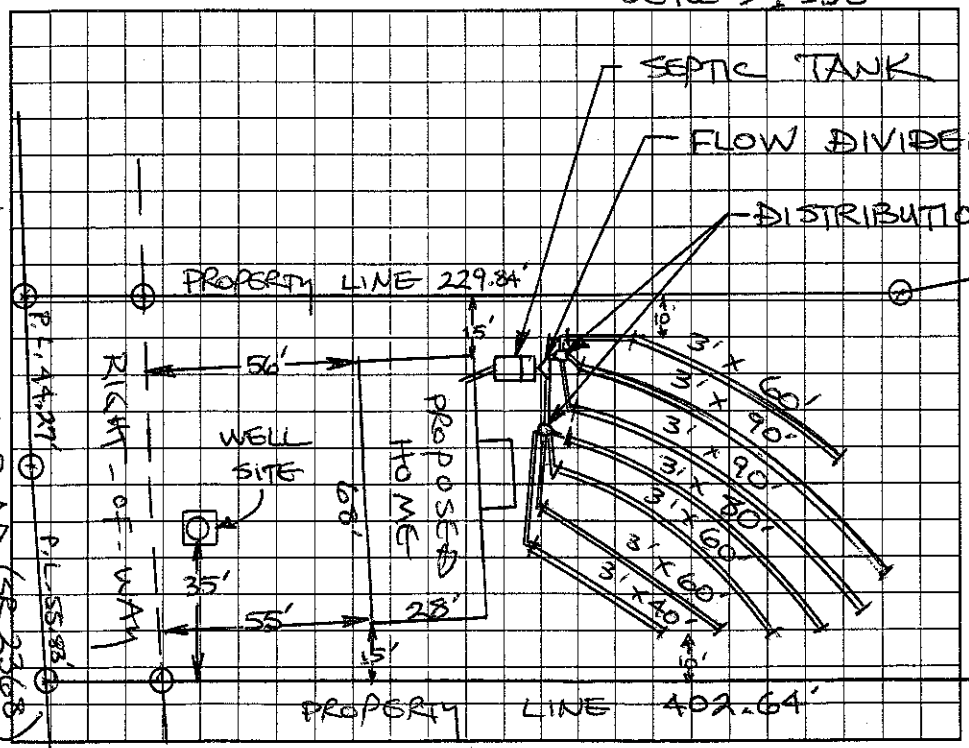

AS BUILT SKETCH

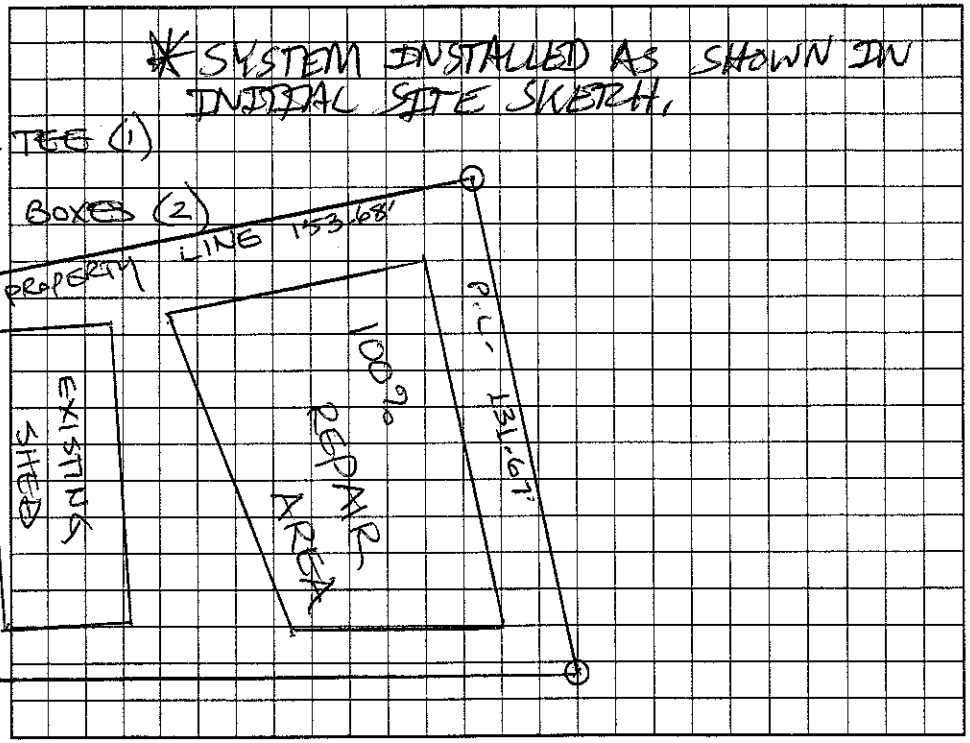

Permit can be suspended or revoked if any false information is supplied toward securing the permit/any unauthorized changes are made to the site/any unauthorized changes are made in the installation of the system. Improvement Permit with plat valid without expiration. Improvement Permit with site plan valid for sixty months. Authorization to Construct is valid for a period equal to that of Improvement Permit – not to exceed sixty months.

Signed: _____ date 1-17-03 Installed by: CRAIG THOMPSON 02/26/03

Improvement Permit by: STEVE HEDRICK date 1-17-03 Operation Permit by: Patrick Mitchell date 02/26/03

Authorization to Construct by: STEVE HEDRICK date 1-17-03 Existing System Inspection by: _____ date _____

HEALTH DEPT. COPY: WHITE OWNER COPY (FINAL): YELLOW OWNER COPY (INITIAL): PINK