IREDELL COUNTY HEALTH DEPARTMENT

STATESVILLE 704-878-5305 MOORESVILLE 704-664-5281

IMPROVEMENT PERMIT / AUTHORIZATION TO CONSTRUCT / OPERATION PERMIT / EXISTING SYSTEM INSPECTION

PERMIT# 108716 PIN# ~~4761-99-9052.00~~ 4761-98-8872 DATE 10-15-02

OWNER OR CONTRACTOR TERESA NEWTON PHONE Business 704-363-6969 Home

ADDRESS 525 SHEPHERD ROAD, TROUTMAN NC 28166

LOCATION US 70 E, TR TRIPLETT ROAD, TR HEMLOCK ROAD, 0.65 MILE ON RIGHT

SUBDIVISION WILLIAM C. SHARP BLOCK / SECTION LOT 10 LOT AREA 0.990 ACRE SITE CLASS PS DESIGN FLOW 360 L.T.A.R. 0.25 GAD/FT²

Septic Tank: 1000 Gallons; STB 1012 Date 07/09/02
Pump Tank: Gallons; PT Date
Pump Make: Model Serial No
Nitrification Field: No Fields 1 Square Feet EA. NO 1490 Linear Feet 360
No Lines FOUR Trench Width 36" Max Trench Bottom Depth 36" Gravel Depth N/A

☑ New System ☐ Repair System Type: I. II (III) IV. V. VI
System Description: 25% REDUCTION, GRAVITY
Repair System Description: 50% REDUCTION, PUMP
Maintenance Agreement Required: ☐ Yes ☑ No
☐ Slab ☑ Crawl Space ☐ Basement w/plumbing ☐ Basement wo/plumbing


☑ House/Mod. Home No. Bedrooms 3
☐ Mobile Home No. Bathrooms 2
☐ Business No. Employees
☐ Other

Water Supply: ☑ Individual ☐ Public ☐ Community
WELL


Comments/Conditions: ① KEEP SYSTEM MAXIMUM FEASIBLE DISTANCE FROM WELL (80') ② INSTALL 25% REDUCTION SYSTEM ON CONTOUR AS FLAGGED

Comments/Conditions: SEPTIC TANK INSTALLED USING SEPTIC MARKER & TUFF TIGHT FILTER

INITIAL SITE SKETCH

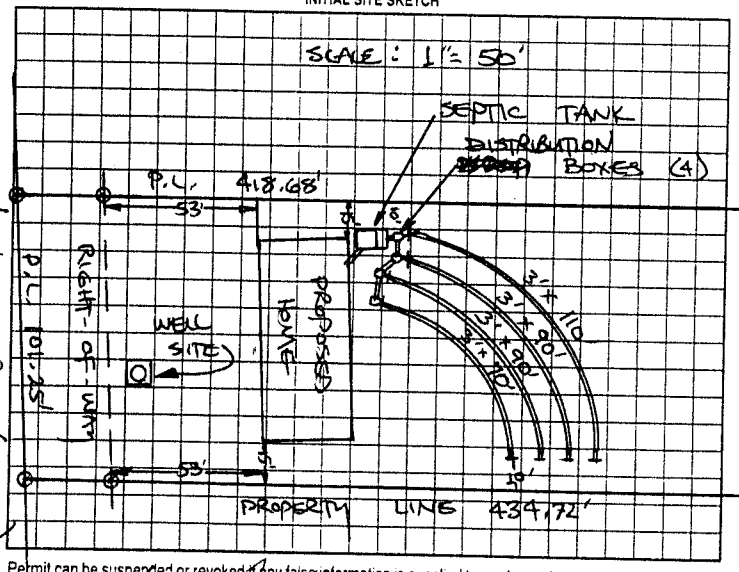

AS BUILT SKETCH

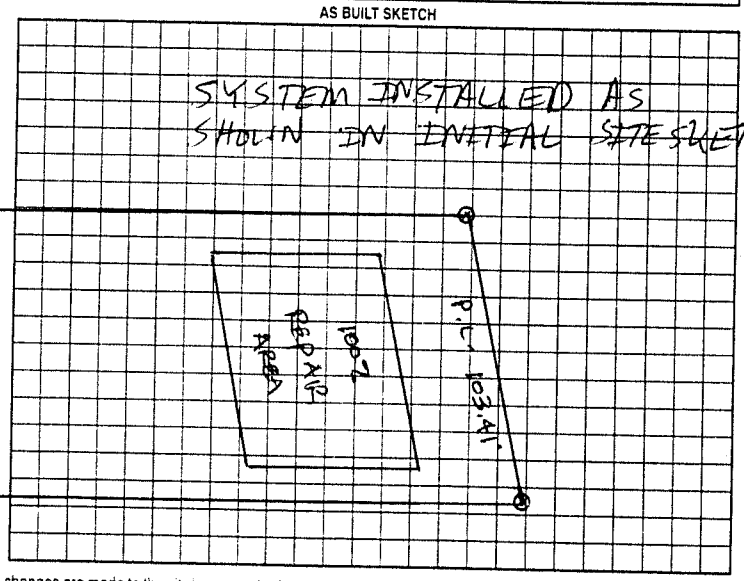

Permit can be suspended or revoked if any false information is supplied toward securing the permit/any unauthorized changes are made to the site/any unauthorized changes are made in the installation of the system. Improvement Permit with plat valid without expiration. Improvement Permit with site plan valid for sixty months. Authorization to Construct is valid for a period equal to that of Improvement Permit - not to exceed sixty months

Signed: Teresa Newton date

Improvement Permit by: STEVE HEDRICK date 10-15-02

Authorization to Construct by: STEVE HEDRICK date 10-15-02

Installed by A-1 BACKHOE

Operation Permit by: Patricia Mitchell date 11/01/02

Existing System Inspection by: date

HEALTH DEPT. COPY: WHITE OWNER COPY (FINAL): YELLOW OWNER COPY (INITIAL): PINK