now called (Hemlock Haven) Subdivision THIS PERMIT VOIDS PREVIOUS ISSUED 11-19-02

IREDELL COUNTY HEALTH DEPARTMENT

STATESVILLE 704-878-5305 MOORESVILLE 704-664-5281

(L) **IMPROVEMENT PERMIT / AUTHORIZATION TO CONSTRUCT / OPERATION PERMIT / EXISTING SYSTEM INSPECTION**

PERMIT# 108699 PIN# 4761-99-~~8122~~ 8183 DATE 3-29-03

OWNER OR CONTRACTOR TERESA NEWTON PHONE: Business 704-363-6964 Home 704-528-7120

ADDRESS 525 SHEPHERD ROAD, TROUTMAN, NC 28166

LOCATION US 70 EAST, TR TRIPLETT ROAD, TR HEMLOCK ROAD, 0.55 MILE ON RIGHT

SUBDIVISION ~~WILLIAM C. SCOTT~~ BLOCK / SECTION LOT 7 LOT AREA 1.119 ACRES SITE CLASS. RS DESIGN FLOW 480 L.T.A.R. 0.30 GPD/FT²

Septic Tank: 1000 Gallons; STB 1012 Date 08/26/02
Pump Tank: Gallons; PT Date
Pump Make: Model Serial No.
Nitrification Field: No Fields 1 Square Feet Eq. to 1600 Linear Feet 400
No Lines SIX Trench Width 36" Max Trench Bottom Depth 36" Gravel Depth N/A

☑ New System ☐ Repair System Type: I, II, (III), IV, V, VI
System Description: 25% REDUCTION, GRAVITY
Repair System Description: 50% REDUCTION, ALTERNATING PUMP
Maintenance Agreement Required: ☐ Yes ☑ No

☑ House/Mod. Home ☑ Mobile Home ☐ Business ☐ Other
No. Bedrooms 4 No. Bathrooms 2 No. Employees


☐ Slab ☑ Crawl Space ☐ Basement w/plumbing ☐ Basement wo/plumbing

Water Supply: ☑ Individual ☐ Public ☐ Community WELL


Comments/Conditions: KEEP SYSTEM MINIMUM 100 FEET FROM WELL (15A NCAC 18A .1956 (6)(9))

Comments/Conditions: -SEPTIC TANK INSTALLED USING TUFF-TIGHT FILTER & MARKER,

INITIAL SITE SKETCH

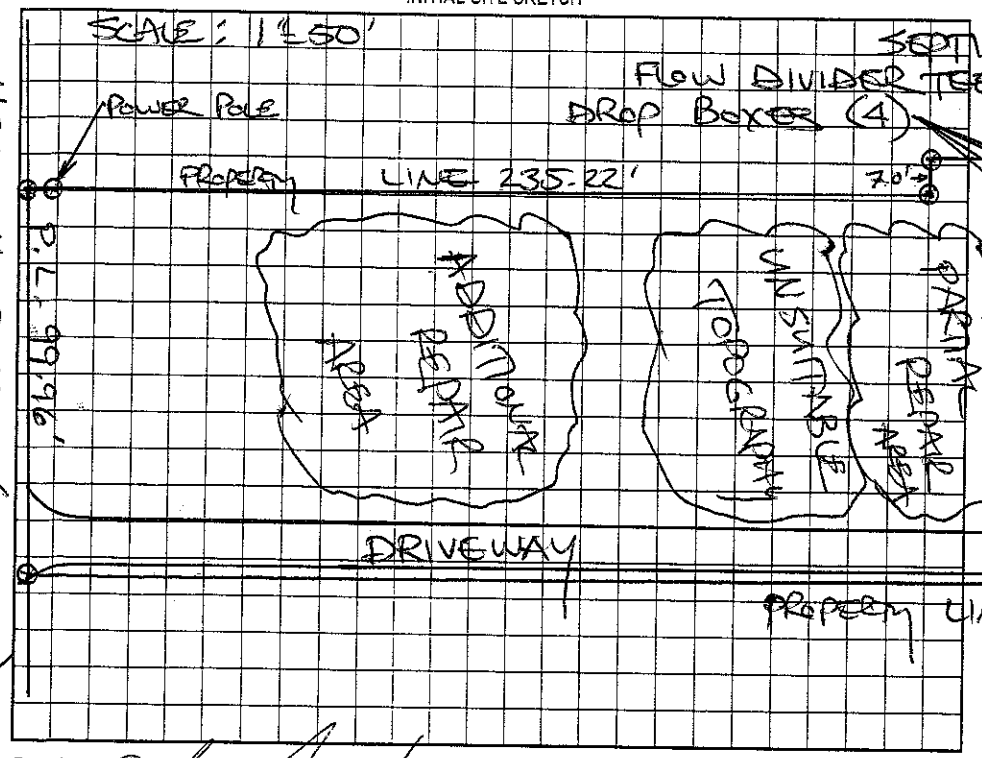

AS BUILT SKETCH

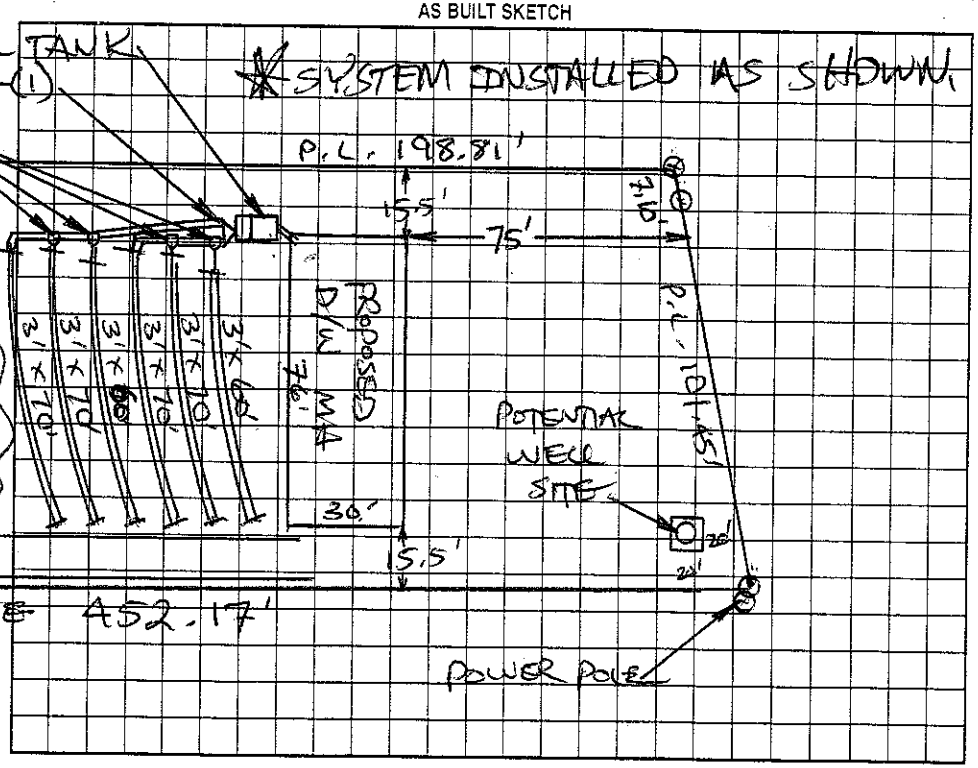

Permit can be suspended or revoked if any false information is supplied toward securing the permit/any unauthorized changes are made to the site/any unauthorized changes are made in the installation of the system. Improvement Permit with plat valid without expiration. Improvement Permit with site plan valid for sixty months. Authorization to Construct is valid for a period equal to that of Improvement Permit – not to exceed sixty months.

Signed: Steve Hedrick for date 3-31-03 Installed by: CRAIG THOMPSON 04/03/03

Improvement Permit by: STEVE HEDRICK date 3-29-03 Operation Permit by: Patricia Mitchell date 04/03/03

Authorization to Construct by: STEVE HEDRICK date 3-29-03 Existing System Inspection by: date

HEALTH DEPT. COPY: WHITE OWNER COPY (FINAL): YELLOW OWNER COPY (INITIAL): PINK