IREDELL COUNTY HEALTH DEPARTMENT

STATESVILLE 704-878-5305 MOORESVILLE 704-664-5281

IMPROVEMENT PERMIT / AUTHORIZATION TO CONSTRUCT / OPERATION PERMIT / EXISTING SYSTEM INSPECTION

PERMIT# 093831 PIN# 4762 02 3500 (PT) DATE 1-23-01

OWNER OR CONTRACTOR MARK CARSON PHONE: Business Home 871-9281

ADDRESS 206 SALISBURY RD, STATESVILLE, NC 28677

LOCATION US 70 E, TR SHILOH, TL CLEMENTS, TR BEVIS, TR COMMAIL, LOT AT END ON RIGHT

SUBDIVISION BLOCK / SECTION LOT LOT AREA 12.43 ACRES SITE CLASS PS DESIGN FLOW 360 L.T.A.R. 0.30 GPD/FT²

Septic Tank: 1000 Gallons; STB 1000 Date 2-20-01
Pump Tank: Gallons; PT Date
Pump Make: Model Serial No.
Nitrification Field: No Fields 1 Square Feet 1200 Linear Feet 400
No Lines FOUR Trench Width 36" Max Trench Bottom Depth 36" Gravel Depth 12"

☑ New System ☐ Repair System Type: I II III IV V VI
System Description: CONVENTIONAL GRAVITY
Repair System Description: CONVENTIONAL GRAVITY
Maintenance Agreement Required: ☐ Yes ☑ No
☐ Slab ☐ Crawl Space ☐ Basement w/plumbing ☐ Basement wo/plumbing


☑ House/Mod. Home No. Bedrooms 3
☐ Mobile Home No. Bathrooms 2
☐ Business No. Employees
☐ Other

Water Supply: ☑ Individual ☐ Public ☐ Community WELL


Comments/Conditions:
PROPERTY LINE 274.14' (2 ACRE)

Comments/Conditions: ① ZABEL FILTER INSTALLED AS SHOWN WITH MARKER

INITIAL SITE SKETCH

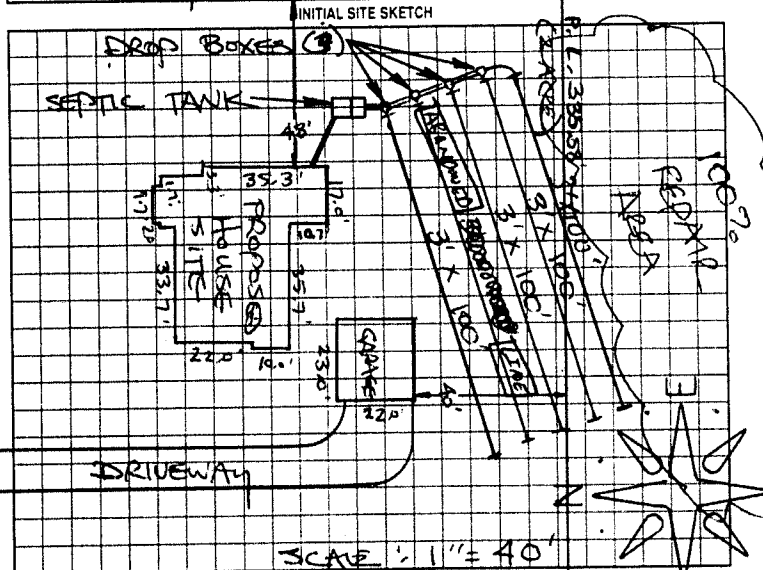

AS BUILT SKETCH

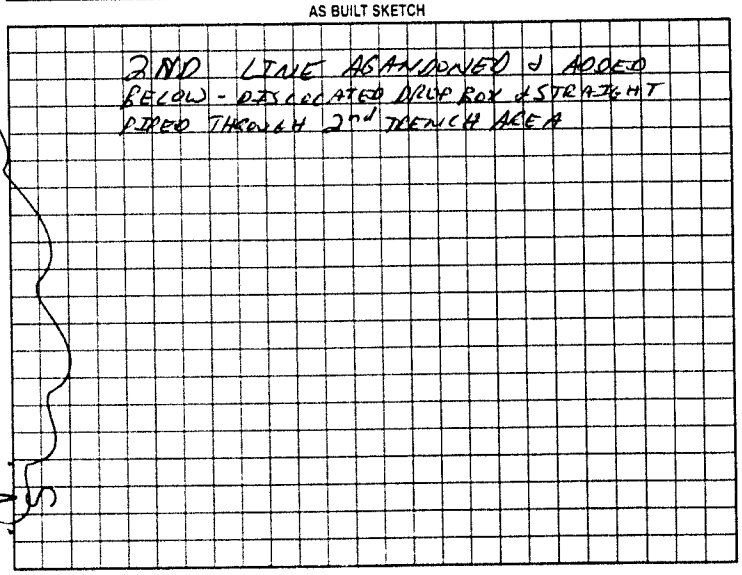

Permit can be suspended or revoked if any false information is supplied toward securing the permit, any unauthorized changes are made to the site, any unauthorized changes are made in the installation of the system. Improvement Permit with plat valid without expiration. Improvement Permit with site plan valid for sixty months. Authorization to Construct is valid for a period equal to that of Improvement Permit – not to exceed sixty months.

Signed: Kimberly Cox Carson date 1-23-01 Installed by DELLINGER

Improvement Permit by: STEVE HEDRICK date 1-23-01 Operation Permit by: RRI date 2-10-01

Authorization to Construct by: STEVE HEDRICK date 1-23-01 Existing System Inspection by: date

HEALTH DEPT COPY WHITE OWNER COPY (FINAL) YELLOW OWNER COPY (INITIAL) PINK