IREDELL COUNTY HEALTH DEPARTMENT

Statesville Office (704) 878-5305 Mooresville Office (704) 660-3625 PERMIT # 207399

IMPROVEMENT PERMIT / AUTHORIZATION TO CONSTRUCT / OPERATION PERMIT / EXISTING SYSTEM

PIN # 4762022996

APPLICANT: Steven White APPLICANT ADDRESS: 274 Yacht Rd Mooresville NC 28117

SITE ADDRESS: 119 Cottontail Ln Statesville NC 28677 PHONE: 980-722-1544 ALT. PHONE: N/A

SITE DIRECTIONS: 70 E T/R Shiloh T/L Clements T/R on Bevis T/R on Cottontail Lot on left

SUBDIVISION: Loyd Acres SECTION: 52 LOT # 8 LOT AREA: 0.46ac DESIGN FLOW: 360 L.T.A.R.: 0.3

Septic Tank 1000 (gal) STB 160-1000 Date 5-26-15
Pump Tank (gal) PT Date
Pump Make Model Serial #
Nitrification Fields 1 # Lines 5 Linear Ft: 302
Trench Width 36" Max. Trench Bottom Depth 36" Gravel Depth N/A


[X] New System [ ] Repair [ ] Expansion System Type: I II [III] IV V VI
System Description: 25% Reduction
Repair System Description: Repair exempt per 15A NCAC 18A 1945
Maintenance Agreement Required: [ ] YES [X] NO
[X] GRAVITY [ ] PRESSURE

[X] Residence No. Bedrooms 3
[ ] Business No. Persons 6
[ ] Other No. Employees
[ ] Slab [ ] Crawl Space
[ ] Basement w/plumbing [X] Basement w/o plumbing

Water Supply: [X] Private [ ] Public [ ] Community

Comments / Conditions: Install 25% reduction on contour with serial distribution. Maintain minimum 36" trench depth.

INITIAL SITE SKETCH

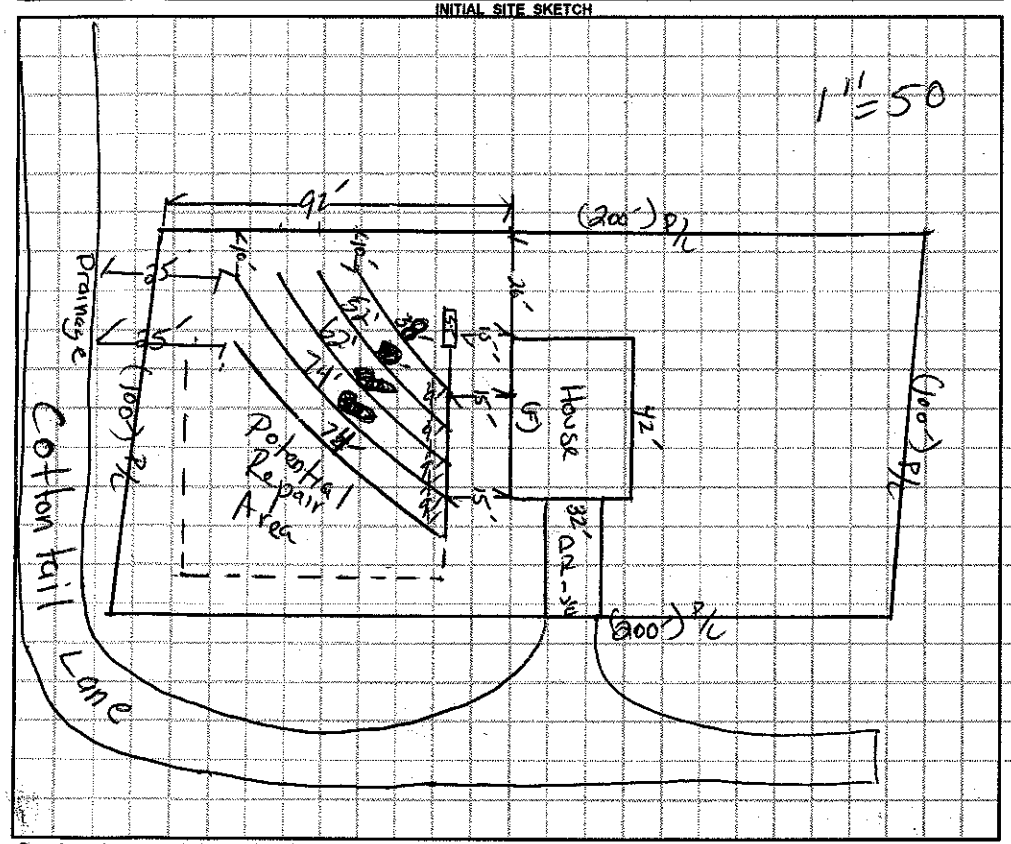

AS BUILT SKETCH

- Red Polylok fitting installed
- 2" PVC ST marker installed
- Quick 4 Chambers installed
- Installed as drawn

Permit can be suspended or revoked if any false information is supplied toward securing the permit / any unauthorized changes are made to the site / any unauthorized changes are made in the installation of the system. **CONTACT A LOCATOR SERVICE PRIOR TO ANY EXCAVATION**

[ ] **IMPROVEMENT PERMIT** *with plat valid without expiration.* [X] **IMPROVEMENT PERMIT** *with site plan valid for 60 mos.* [X] **AUTHORIZATION TO CONSTRUCT** *valid for period equal to IMPROVEMENT PERMIT--not to exceed 60 mo.*

Owner / Applicant Signature: Sherry White Date: 3-12-15 Installed by: Hayes + Byers Rental

IMPROVEMENT PERMIT by: Debt Ashburn Date: 03/11/15 OPERATION PERMIT by: Justin Henderson Date: 6-29-15

AUTHORIZATION TO CONSTRUCT by: Debt Ashburn Date: 03/12/15 Existing System Inspected by: Date:

Health Dept. Copy - WHITE Applicant (Final Approval) - YELLOW Applicant (Conditional Approval) - PINK

IREDELL COUNTY HEALTH DEPARTMENT
JANE MURRAY, RN BSN MS
HEALTH DIRECTOR

Public Health
Prevent. Promote. Protect.
Iredell County Health Department

Voluntary Relinquishment of Administrative Appeal Rights
(Completion of Form by Property Owner)

3-12-15 (Date)

Owner: Steven White
Address: 274 Yacht Rd
Mooresville NC 28117

Subject: Voluntary Relinquishment of Administrative Appeal Rights

(specify Permit ID/owner's name/property location/site legal description):
207399 / Steven White / 119 Cottontail Ln / Lot 8 Loyd Acres

I, Sherry White, voluntarily relinquish my rights to pursue a formal appeal through the Office of
(print full name)

Administrative Hearings pursuant to NC General Statute 130A-24 and 150B-23 and all other applicable provisions of Chapter 150B for the above referenced permit in order for the authorized agent/local health department to issue the applicable permit (new IP and/or CA) for the site. I understand by completing this form the previous permit issued on 9-15-10 (date) for a system

25% Reduction
(system name)

for the site will be "revoked" immediately by the authorized agent/local health department.

Sherry White
Signature of Property Owner

Central Office
318 Turnersburg Hwy
Statesville, NC 28625
704 878-5300

Mooresville Office
610 E. Center Avenue
Mooresville, NC 28115
704 664-5281

Environmental Health
349 N. Center Street
Statesville, NC 28677
704 878-5358

http://www.co.iredell.nc.us/Departments/Health/

IREDELL COUNTY HEALTH DEPARTMENT

STATESVILLE 704-878-5305 MOORESVILLE 704-664-5281

IMPROVEMENT PERMIT / AUTHORIZATION TO CONSTRUCT / OPERATION PERMIT / EXISTING SYSTEM INSPECTION

PERMIT # [redacted] 207399 PIN # 4762-02-2996 DATE 9-15-10

OWNER or APPLICANT Steve White PHONE: Business 980 722 1544 Home:

OWNER or APPLICANT ADDRESS 119 Cottontail Lane

LOCATION / DIRECTIONS Hwy 70E to (R) on Shiloh (L) on Clements (R) on Birk, (R) on Cottontail, Lot on Left

SUBDIVISION Loyd Acres BLOCK / SECTION LOT # 8 LOT AREA .465 DESIGN FLOW 360 L.T.A.R. .25

Septic Tank 1000 Gallons: STB Date

Pump Tank Gallons: P T Date

Pump Make Model Serial #

Nitrification Field No Fields 1 No Lines 4 Linear Feet 360

Trench Width 36" Max. Trench Bottom Depth 36" Gravel Depth n/a ☐ GRAVITY ☐ PRESSURE

☑ New System ☐ Repair ☐ Expansion System Type I II (III) IV V VI

System Description: 25% Reduction Gravity

Repair System Description: 50% Reduction LPP

Maintenance Agreement Required ☐ YES ☑ NO


☑ Residence No. Bedrooms 3 ☐ Business No. Persons ☐ Other No. Employees ☐ Slab ☐ Crawl Space ☑ Basement w/plumbing ☐ Basement w/o plumbing

Water Supply: ☑ Private ☐ Public ☐ Community


Comments / Conditions

Comments / Conditions

INITIAL SITE SKETCH

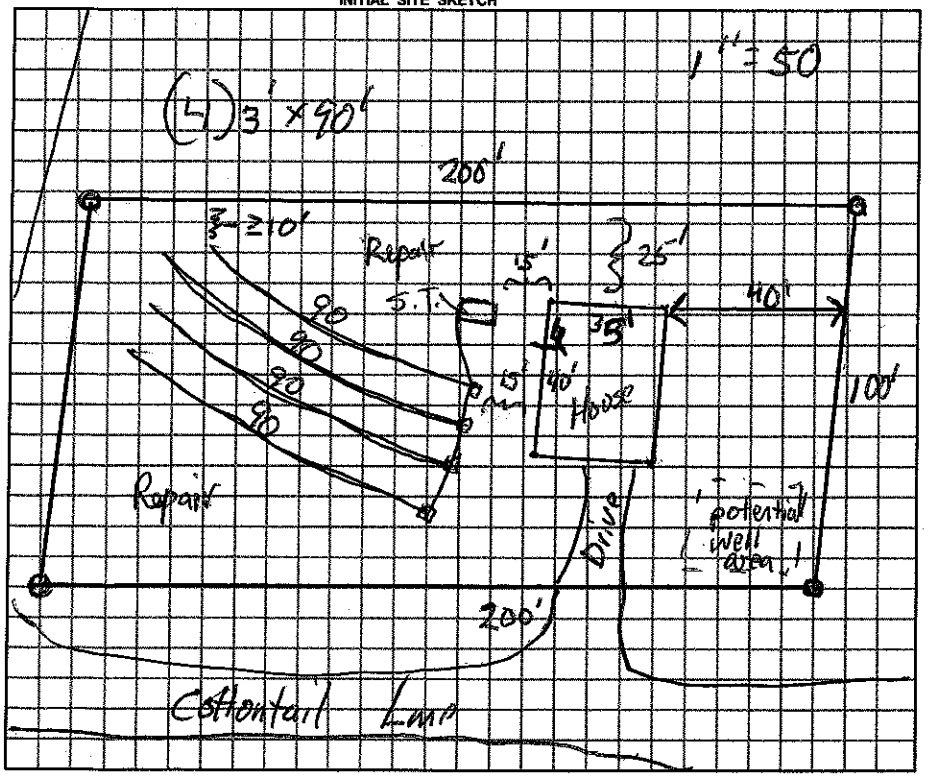

AS BUILT SKETCH

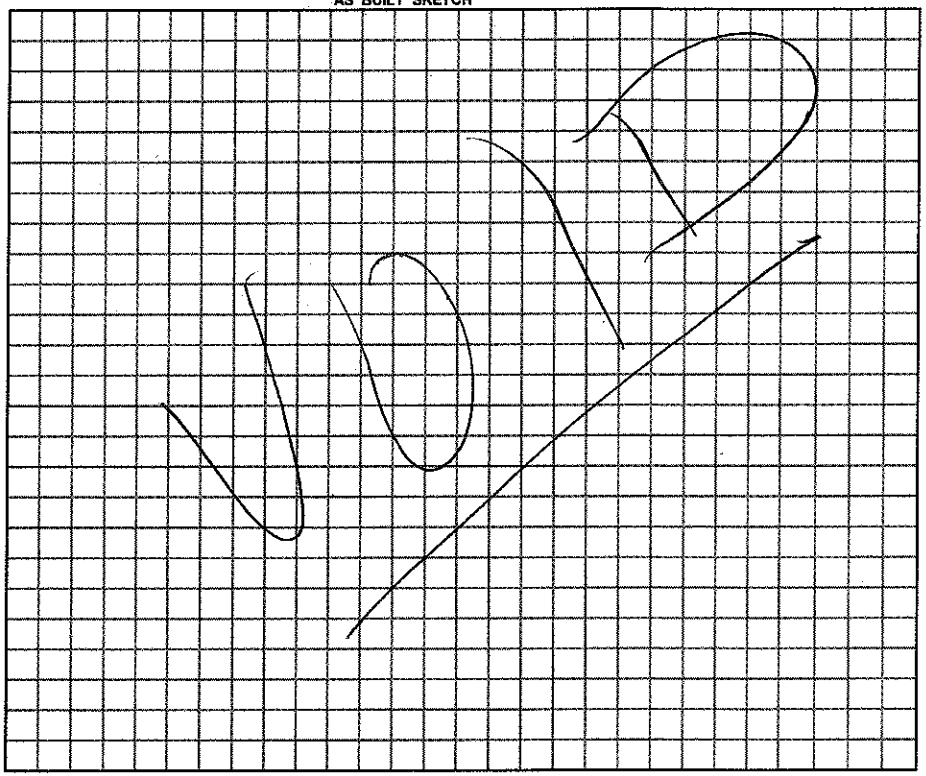

Permit can be suspended or revoked if any false information is supplied toward securing the permit / any unauthorized changes are made to the site / any unauthorized changes are made in the installation of the system.

☐ *IMPROVEMENT PERMIT w / plan valid without expiration.* ☑ *IMPROVEMENT PERMIT w / site plan valid for 60 mos.* ☑ *AUTHORIZATION TO CONSTRUCT valid for period equal to IMPROVEMENT PERMIT-not to exceed 60 mo.*

Owner / Applicant Signature: Steve White Date 9-15-10

Improvement Permit by: James [illegible] 12/12/14 Date 9-15-10

Authorization to Construct by: Kristin Mendenhall Date 12-11-14

YOU SHOULD CONTACT A LOCATOR SERVICE PRIOR TO ANY EXCAVATION.

Installed by:

Operation Permit by: Date:

Existing System Inspected by: Date:

WHITE COPY Environmental Health YELLOW COPY (Final) Owner / Applicant PINK COPY (Initial) Owner / Applicant