IREDELL COUNTY HEALTH DEPARTMENT

Statesville Office (704) 878-5305 Mooresville Office (704) 660-3625 PERMIT # 203705

IMPROVEMENT PERMIT / AUTHORIZATION TO CONSTRUCT / OPERATION PERMIT / EXISTING SYSTEM

PIN # 4762032803

APPLICANT: Russell Reichart APPLICANT ADDRESS: 256 Clements Rd

SITE ADDRESS: 256 Clements Rd PHONE: 704-873-6252 ALT. PHONE: N/A

SITE DIRECTIONS: 70E to Shiloh Rd T/R go 2 to 3 miles T/L Clements house on right


SUBDIVISION: N/A SECTION: N/A LOT # N/A LOT AREA: 1ac DESIGN FLOW: EX L.T.A.R.: EX

Septic Tank	EX	(gal)	STB	EX	Date	EX	☐ New System	☐ Repair	☐ Expansion	System Type: I (II) III IV V VI	☒ Residence	No. Bedrooms	EX	Water Supply
Pump Tank	N/A	(gal)	PT	N/A	Date	N/A	System Description:	Existing			☐ Business	No. Persons		☑ Private
Pump Make	N/A	Model		N/A	Serial #	N/A	Repair System Description:				☐ Other	No. Employees		☐ Public
# Nitrification Fields	EX	# Lines		EX	Linear Ft:	EX	Maintenance Agreement Required:	☐ YES	☒ NO		☐ Slab	☐ Crawl Space		☐ Community
Trench Width	EX	Max. Trench Bottom Depth		EX	Gravel Depth	EX		☒ GRAVITY	☐ PRESSURE		☒ Basement w/plumbing			☐ Basement w/o plumbing

Comments / Conditions: All pools must be 35' from any part of STS

INITIAL SITE SKETCH

AS BUILT SKETCH

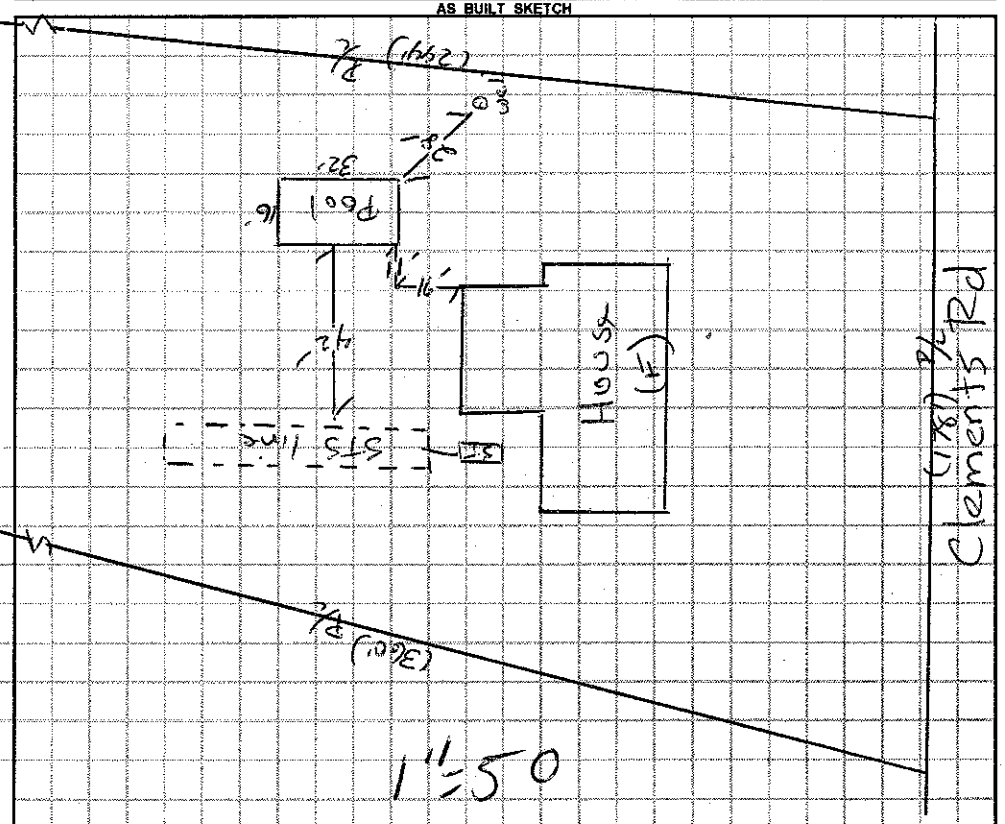

Permit can be suspended or revoked if any false information is supplied toward securing the permit / any unauthorized changes are made to the site / any unauthorized changes are made in the installation of the system. **CONTACT A LOCATOR SERVICE PRIOR TO ANY EXCAVATION**

☐ **IMPROVEMENT PERMIT** *with plat valid without expiration.* ☐ **IMPROVEMENT PERMIT** *with site plan valid for 60 mos.* ☐ **AUTHORIZATION TO CONSTRUCT** *valid for period equal to IMPROVEMENT PERMIT--not to exceed 60 mo.*

Owner / Applicant Signature: Russell C. Reichart Date: 6-5-14 Installed by:

IMPROVEMENT PERMIT by: Date: OPERATION PERMIT by: Date:

AUTHORIZATION TO CONSTRUCT by: Date: Existing System Inspected by: Robert A. Shaw Date: 06/04/14

Health Dept. Copy - WHITE Applicant (Final Approval) - YELLOW Applicant (Conditional Approval) - PINK