IREDELL COUNTY HEALTH DEPARTMENT

Statesville Phone TR 3-7271 Mooresville Phone No. 664-5281

PERMIT TO INSTALL SEPTIC TANK

Permit No. 126 Permit Date 12-30 1972

Owner GENTRY BREWER Address STATESVILLE, N.C.

Installed By YORK RUFTY Address STONY POINT, N.C.


Location of Property 80E - RIGHT ON Rd #2318 STAGEN Ch Rd) CROSS CREEK - LEFT ON Rd. #2358 - LLOYD HYRES -

Tank		Capacity		Length of Lines		Fixtures	
Block	( )	1000	(✓)	225'	(✓)	No. of Baths	(1½)
Precast	(✓)	1250	( )	250'	( )	Dishwasher	( )
		1500	( )	Other		Garbage Grdr.	( )
		Other				Other	

NOTIFY HEALTH DEPARTMENT AT LEAST EIGHT HOURS BEFORE TANK IS TO BE INSPECTED.

Final Inspection 12-30 1972 Approved (✓) Disapproved ( )

Remarks

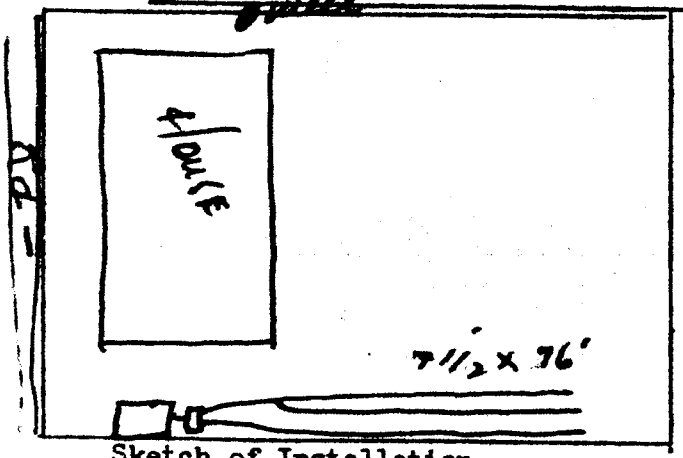

Sketch of Installation

Sanitarian