04203

IREDELL COUNTY HEALTH DEPARTMENT

(SEPTIC TANK) IMPROVEMENTS PERMIT AND CERTIFICATE OF COMPLETION
(Ground Absorption Sewage Disposal System – G. S. Chapter 130-Article 13C)

OWNER OR CONTRACTOR Charles Clubb DATE 3-5-86 PERMIT NO. _____

PHONE: Business _____ Home _____

LOCATION 70E. TR on Shiloh Ch. Rd (SR 2318) TR on Clement Rd TR on Davis Rd Rt. Property S. R. No. _____

SUBDIVISION NAME _____ LOT NO. _____ SECTION OR BLOCK NO. _____

House (✓) Mobile Home ( ) Business ( ) Other _____


No. Bedrooms 2 No. Bathrooms 1

Garbage Disposal Unit	Yes ( )	No (✓)	
Auto. Dishwasher	Yes (✓)	No ( )	
Auto. Wash. Machine	Yes (✓)	No ( )	
Site Suitable	Yes (✓)	No ( )	

Lot Area 1/4 Acre

Character & Porosity of Soil Clayey Sandy Loam
Percolation Rate 2-6 Min.
Topography Rolling
Depth to Water Table 10'
Rock or other impervious formations None

_____ Basement with Plumbing _____ Basement without Plumbing ✓ No Basement

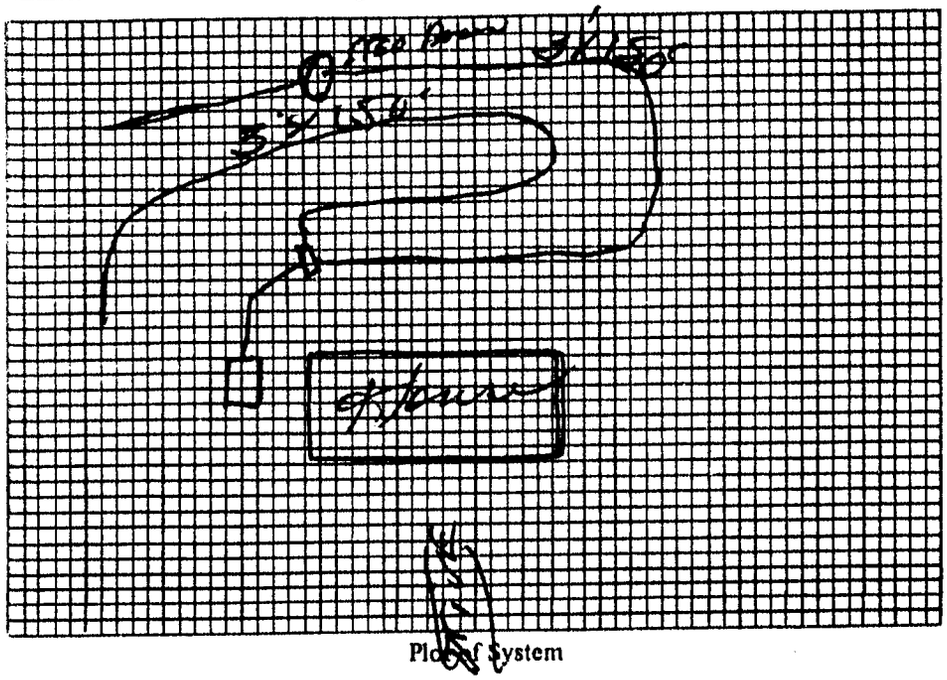

Plot Plan of System

Size of Tank 1000 Gals.
Nitrification Field:
No. of Lines 2
Sq. Ft. 900 Linear Ft. 300
Depth of Stone in Lines 18"
Water Supply: Individual (✓)
Public ( )

Installed by Donald Lackey

I understand and agree to install septic tank system as specified on this Improvements Permit.

Signed: _____

IMPROVEMENTS PERMIT BY _____

COMMENTS: _____

CERTIFICATE OF COMPLETION BY [signature] DATE 3/3/86

EXISTING SYSTEM CHECKED BY: _____ DATE _____

CONSTRUCTION MUST COMPLY WITH ALL OTHER APPLICABLE STATE AND LOCAL REGULATIONS.

Permit is VOID if any unauthorized changes are made in installation of system and/or if any false information is supplied in making Improvements Permit.

Health Dept. Copy: White Inspection Dept. Copy: Yellow Sanitarian's Copy: Pink Owner's Copy: Gold