IREDELL COUNTY HEALTH DEPARTMENT

STATESVILLE 704-878-5305 MOORESVILLE 704-664-5281

IMPROVEMENT PERMIT / AUTHORIZATION TO CONSTRUCT / OPERATION PERMIT / EXISTING SYSTEM INSPECTION

PERMIT# ~~45348~~ 145610 PIN# 4762148641 DATE 9-24-07

OWNER OR APPLICANT Meredith Homes PHONE: Business 704-664-0515 Home

ADDRESS 143 Buster Bayne Lane Mooresville NC 28115

LOCATION 70E (R) Shiloh (L) Clements

SUBDIVISION BLOCK / SECTION LOT LOT AREA 10. AC SITE CLASS. PS DESIGN FLOW 360 L.T.A.R. .60

Septic Tank: 1000 Gallons: STB 1000 Date 6-30-07

Pump Tank: Gallons: PT Date

Pump Make: Model Serial No.

Nitrification Field: No Fields Square Feet 600 Linear Feet 150

No Lines 2 Trench Width 36" Max Trench Bottom Depth 36"

☐ New System ☐ Repair ☐ Expansion System Type: I II III IV V VI

System Description: 250 Gravity

Repair System Description: 250 pump

Maintenance Agreement Required: ☐ Yes ☐ No

☑ House/Mod. Home ☐ Mobile Home ☐ Business ☐ Other

No. Bedrooms 3 No. Persons No. Employees


Water Supply: ☑ Individual ☐ Public ☐ Community

Gravel Depth 12" ☑ Gravity ☐ Pressure ☐ Slab ☑ Crawl Space ☐ Basement w/plumbing ☐ Basement wo/plumbing

Comments:/Conditions:

Clements Rd 672

INITIAL SITE SKETCH

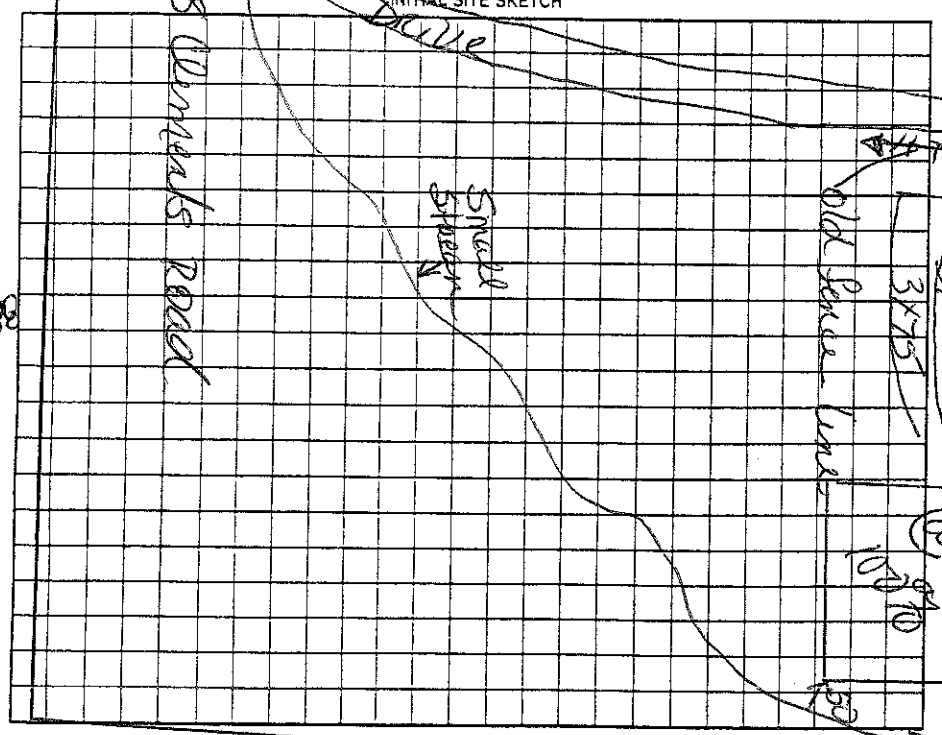

Comments:/Conditions:


NOT to scale

Construct on contour

Maintain all setbacks

Maintain 100' runway from well

AS BUILT SKETCH

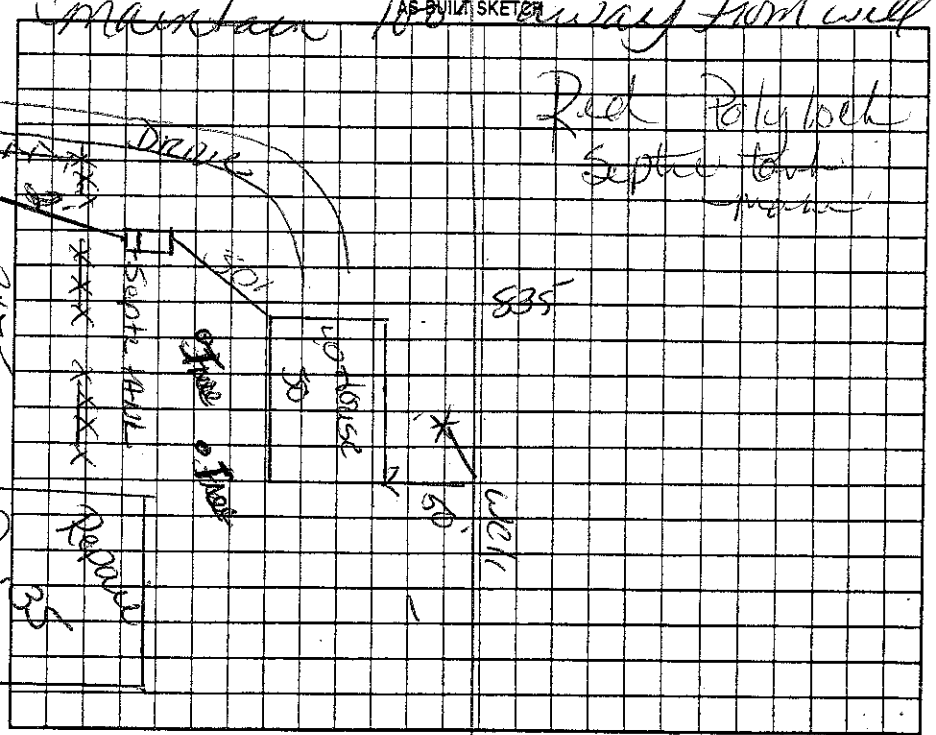

Permit can be suspended or revoked if any false information is supplied toward securing the permit/any unauthorized changes are made to the site/any unauthorized changes are made in the installation of the system. Improvement Permit with plat valid without expiration ☐ Improvement Permit with site plan valid for sixty months ☐ Authorization to Construct is valid for a period equal to that of Improvement Permit – not to exceed sixty months.

Signed: date 9-26-07 Installed by: Madison Brothers

Improvement Permit by: Lee Cook date 9-26-07 Operation Permit by: Lee Cook date 9-26-07

Authorization to Construct by: Lee Cook date 9-26-07 Existing System Inspection by: date

HEALTH DEPT. COPY: WHITE OWNER COPY (FINAL): YELLOW OWNER COPY (INITIAL): PINK