IREDELL COUNTY HEALTH DEPARTMENT

STATESVILLE 704-878-5305 MOORESVILLE 704-664-5281

IMPROVEMENT PERMIT / AUTHORIZATION TO CONSTRUCT / OPERATION PERMIT / EXISTING SYSTEM INSPECTION

PERMIT# 094586 PIN# 4762 21 7515 PT DATE 02-26-01

OWNER OR CONTRACTOR FLEETWOOD HOMES PHONE: Business 526-7120 Home

ADDRESS 1040 CHARLOTTE HWY, TROUTMAN, NC 28625

LOCATION 70E, @ BETHESDA, @ FAIRWINDS, ATEND ON LEFT

SUBDIVISION FAIRWINDS BLOCK / SECTION LOT 32 LOT AREA 9.1196 Acres SITE CLASS PS DESIGN FLOW 360 L.T.A.R. .25

Septic Tank: 1000 Gallons; STB BRD 794 Date 1-5-01

Pump Tank: Gallons; PT Date

Pump Make: Model Serial No.

Nitrification Field: No Fields 1 Square Feet 1440' Linear Feet 480'

No Lines 4 Trench Width 36" Max Trench Bottom Depth 36" Gravel Depth 12"

[X] New System [ ] Repair System Type: I (II) III. IV. V VI

System Description: CONV GRAV

Repair System Description: CONV GRAV

Maintenance Agreement Required: [ ] Yes [X] No

[ ] House/Mod. Home No. Bedrooms 3

[X] Mobile Home No. Bathrooms 2

[ ] Business No. Employees

[ ] Other


[ ] Slab [X] Crawl Space [ ] Basement w/plumbing [ ] Basement wo/plumbing

Water Supply: [X] Individual [ ] Public [ ] Community WELL


Comments/Conditions: ① CALL PRIOR TO INSTALLATION FOR FLAGGIT ② INSTALL LINES ON CONTOUR ③ KEEP WELL 100' AWAY FROM SYSTEM

Comments/Conditions: INSTALLED AS SHOWN WITH MARKER & ALCYCOK FILTER

INITIAL SITE SKETCH "NOT TO SCALE"

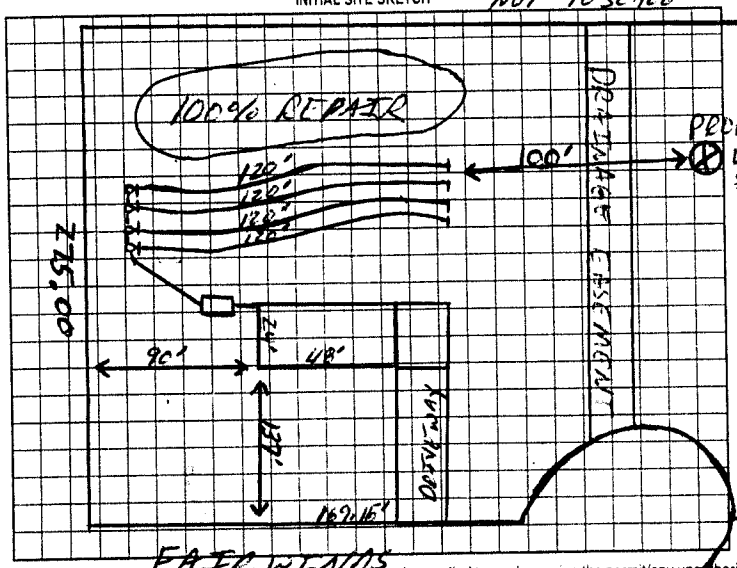

AS BUILT SKETCH

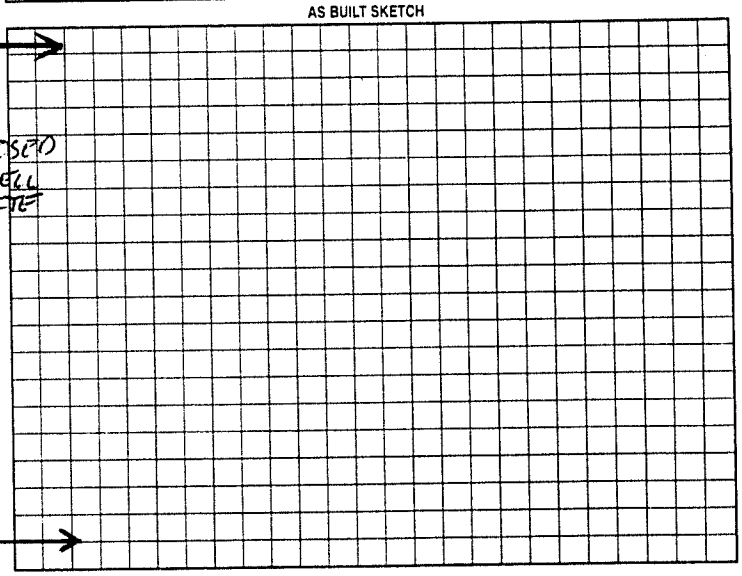

Permit can be suspended or revoked if any false information is supplied toward securing the permit/any unauthorized changes are made to the site/any unauthorized changes are made in the installation of the system. Improvement Permit with plat valid without expiration. Improvement Permit with site plan valid for sixty months. Authorization to Construct is valid for a period equal to that of Improvement Permit – not to exceed sixty months.

Signed: Chad B. Pope date 3-1-01 Installed by: Craig Thompson

Improvement Permit by: Jim Cook REHS date 02-28-01 Operation Permit by: Jim Cook REHS date 03-12-01

Authorization to Construct by: Jim Cook REHS date 02-28-01 Existing System Inspection by: date

HEALTH DEPT COPY WHITE OWNER COPY (FINAL): YELLOW OWNER COPY (INITIAL): PINK