IREDELL COUNTY HEALTH DEPARTMENT

STATESVILLE 704-878-5305 — MOORESVILLE 704-664-5281 — CI

IMPROVEMENT PERMIT / AUTHORIZATION TO CONSTRUCT / OPERATION PERMIT / EXISTING SYSTEM INSPECTION

PERMIT# 106310 PIN# 4762-21-9297 DATE May 1, 02

OWNER OR CONTRACTOR Bethesda Rd. LLC / Schultz Housing PHONE Business Home

ADDRESS P.O. Box 1732 Lincolnton NC 28092 / 134 KOA LANE - STATESVILLE

LOCATION 70 EAST TR Bethesda Road TR Robins Hill Lane AT END on Right

SUBDIVISION FAIRWINDS BLOCK / SECTION LOT 21 LOT AREA 1.186 Ac SITE CLASS PS DESIGN FLOW 360gpd L T A R .03

Septic Tank: 1000 Gallons: STB 1012 Date 12-16-01
Pump Tank: Gallons: PT Date
Pump Make: Model Serial No
Nitrification Field: No Fields 1 Square Feet 1200 Linear Feet 400
No Lines 4 Trench Width 36" Max Trench Bottom Depth 36"


New System ☐ Repair System Type I II III IV V VI
System Description: GRAVITY CONVENTIONAL
Repair System Description: SAME
Maintenance Agreement Required: Yes ☐ No

House/Mod. Home No Bedrooms 3
Mobile Home No Bathrooms 2
Business No Employees
Other
Slab Crawl Space Basement w/plumbing ☐ Basement wo/plumbing

Water Supply: Individual ☐ Public ☐ Community


Comments/Conditions 113.61' 106.87'

INITIAL SITE SKETCH

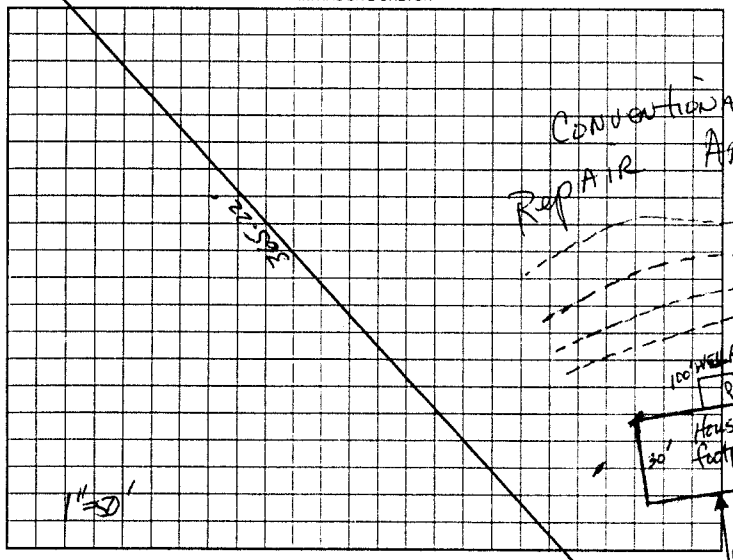

Comments/Conditions 106.87' POLYLOK FILTER & MANIFOLD INSTALLED AS SHOWN

AS BUILT SKETCH

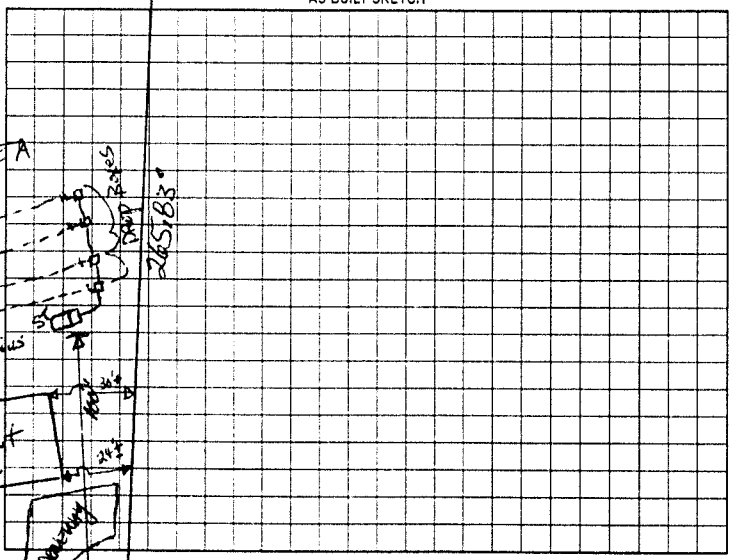

Permit can be suspended or revoked if any false information is supplied toward securing the permit, any unauthorized changes are made to the site, any unauthorized changes are made in the installation of the system. Improvement Permit with plat valid without expiration. Improvement Permit with site plan valid for sixty months. Authorization to Construct is valid for a period equal to that of Improvement Permit – not to exceed sixty months

Signed: 5-2-02 date

Improvement Permit by: 5-1-02 date

Authorization to Construct by: 5-1-02 date

Installed by A-1 BACKHOE

Operation Permit by date 05-03-02

Existing System Inspection by date

HEALTH DEPT COPY WHITE OWNER COPY (FINAL) YELLOW OWNER COPY (INITIAL) PINK