IREDELL COUNTY HEALTH DEPARTMENT

STATESVILLE 704-878-5305 MOORESVILLE 704-664-5281

IMPROVEMENT PERMIT / AUTHORIZATION TO CONSTRUCT / OPERATION PERMIT / EXISTING SYSTEM INSPECTION

PERMIT# 126226 PIN# (35) 4762-21-8848 / 4762-21-9849 (-36) DATE 3-11-05

OWNER OR CONTRACTOR PINNACLE HOUSING GROUP, LP PHONE: Business 704-895-4622 Home 704-902-7773

ADDRESS 16315-F NORTHCROSS DRIVE, HUNTERSVILLE, NC 28078

LOCATION US 70 EAST, TR BETHESDA ROAD, TR FAIRWINDS LANE, LOTS AT END ON RIGHT

SUBDIVISION FAIRWINDS BLOCK / SECTION II LOT (35/36) LOT AREA 1.5406 ACRES SITE CLASS. PS DESIGN FLOW 360 L.T.A.R. 0.25 GAD/FT²

Septic Tank: 1000 Gallons; STB 1012 Date 3-22-04
Pump Tank: ____ Gallons; PT ____ Date ____
Pump Make: ____ Model ____ Serial No. ____
Nitrification Field: No Fields 1 Square Feet EQ TO 1440 Linear Feet 360
No Lines FOUR Trench Width 36" Max Trench Bottom Depth 36" Gravel Depth N/A

☑ New System ☐ Repair System Type: I, II, (III), IV, V, VI
System Description: 25% REDUCTION, GRAVITY
Repair System Description: 50% REDUCTION, LOW PRESSURE
Maintenance Agreement Required: ☐ Yes ☒ No

☑ House/Mod. Home ☐ Mobile Home ☐ Business ☐ Other
No. Bedrooms 3 No. Bathrooms ____ No. Employees ____


Water Supply: ☑ Individual ☐ Public ☐ Community

☐ Slab ☑ Crawl Space ☐ Basement w/plumbing ☐ Basement wo/plumbing


Comments:/Conditions: ① INSTALL 25% REDUCTION SYSTEM ON CONTOUR AS SHOWN ② KEEP SYSTEM MINIMUM 100 FEET FROM WELL

Comments:/Conditions: DANIE HYKES - LC - INSTALLER CALLED. TANK IS 70' TO WELL, ALLOWABLE. SOIL SHEET DOES NOT INDICATE SAPROLITE GREATER THAN 50%.

INITIAL SITE SKETCH

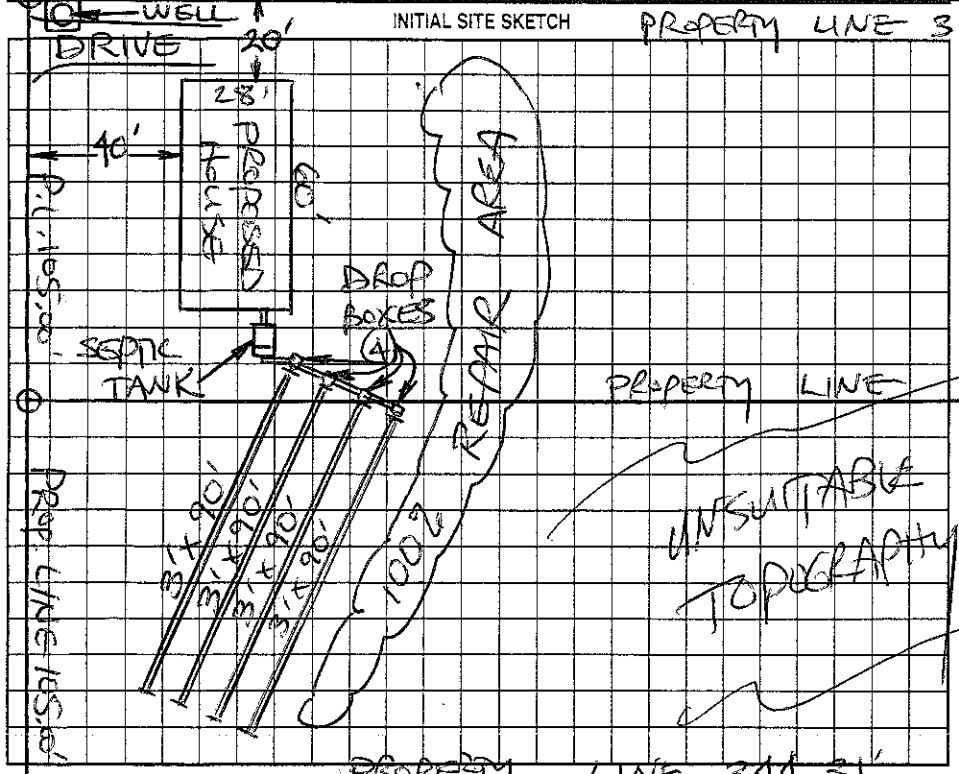

AS BUILT SKETCH

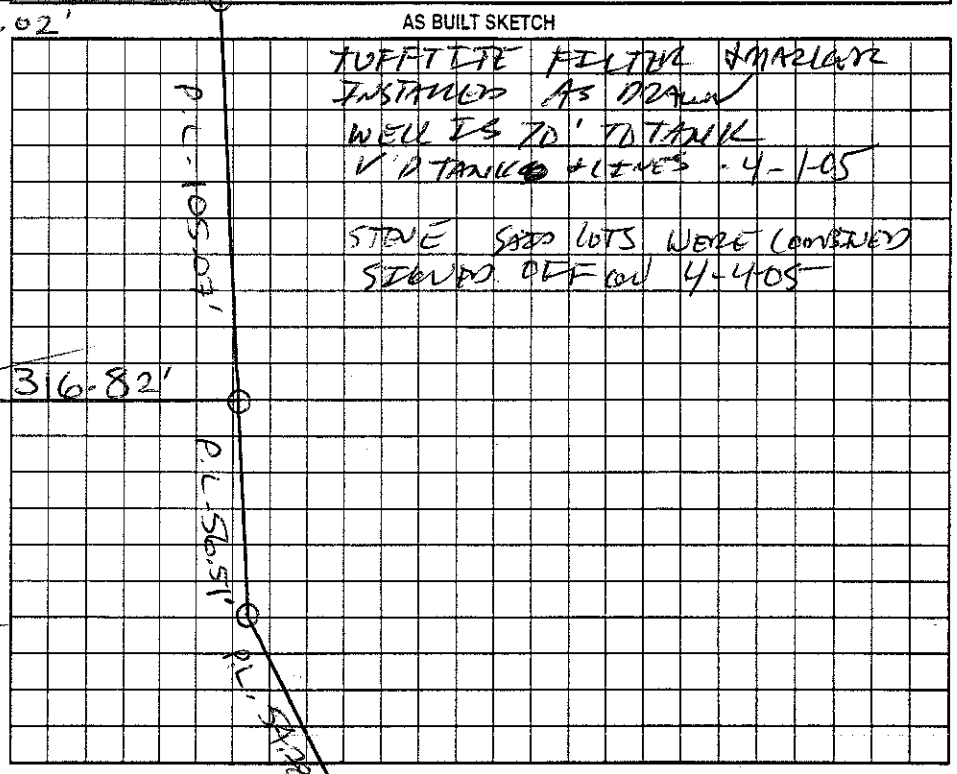

TUFFTITE FILTER FABRIC INSTALLED AS DRAWN
WELL IS 70' TO TANK
V.I.P. TANK & LINES - 4-1-05

STEVE SAID LOTS WERE COMBINED SIGNED OFF ON 4-4-05

Permit can be suspended or revoked if any false information is supplied toward securing the permit/any unauthorized changes are made to the site/any unauthorized changes are made in the installation of the system. Improvement Permit with plat valid without expiration. Improvement Permit with site plan valid for sixty months. Authorization to Construct is valid for a period equal to that of Improvement Permit – not to exceed sixty months.

Signed: [signature] date 3/14/05 Installed by: A-1 BACK HOE

Improvement Permit by: STEVE HEDRICK date 3-11-05 Operation Permit by: [signature] date 4-4-05

Authorization to Construct by: STEVE HEDRICK date 3-11-05 Existing System Inspection by: ____ date ____

HEALTH DEPT. COPY: WHITE OWNER COPY (FINAL): YELLOW OWNER COPY (INITIAL): PINK