CI / CI

IREDELL COUNTY HEALTH DEPARTMENT

STATESVILLE 704-878-5305 MOORESVILLE 704-664-5281

IMPROVEMENT PERMIT / AUTHORIZATION TO CONSTRUCT / OPERATION PERMIT / EXISTING SYSTEM INSPECTION

PERMIT# 102427 PIN# 4762-21-7515, 17 DATE 02-04-02

OWNER OR CONTRACTOR OAKWOOD Homes PHONE: Business _____ Home 704-528-4516

ADDRESS 125 ROBINS HILL LN STATESVILLE NC 28677

LOCATION 70E, (E) BETHESDA, (R) ROBBINS HILL LN, ON LFT LOT 17

SUBDIVISION FAIRWINDS BLOCK / SECTION _____ LOT 17 LOT AREA 0.5653 SITE CLASS PS DESIGN FLOW 360 L.T.A.R. 13

Septic Tank: 1000 Gallons: STB 1012 Date 10-2-01
Pump Tank: _____ Gallons: PT _____ Date _____
Pump Make: _____ Model _____ Serial No. _____
Nitrification Field: No Fields 1 Square Feet 1200' Linear Feet 400'
No Lines 5x80' Trench Width 36" Max Trench Bottom Depth 36"

X New System ☐ Repair System Type: I (II), III, IV, V, VI
System Description: CONV GRAV
Repair System Description: LP PANEL
Maintenance Agreement Required: ☐ Yes X No
Gravel Depth 12" ☐ Slab X Crawl Space ☐ Basement w/plumbing ☐ Basement wo/plumbing


☐ House/Mod. Home No. Bedrooms 3
X Mobile Home DW No. Bathrooms 2
☐ Business No. Employees _____
☐ Other _____

Water Supply: X Individual ☐ Public ☐ Community WELL

Comments/Conditions: (1) KEEP SYSTEM 100' FROM WELL AND ANY NEIGHBORING WELLS (2) INSTALL LINES ON CONTOUR (3) MAINTAIN SETBACKS (4) SYSTEM IS ENTIRELY FLAGGED OUT EVERY 10'. (5) SIGNED OFF ON AL


Comments/Conditions: HOUSE PLANS 14' SHORTER THAN DRAWN. KEEP D/W 15' OFF 249.17' LINE + ADD GAINED WIDTH TO DRIVEWAY SIDE.

INITIAL SITE SKETCH 1"=50'

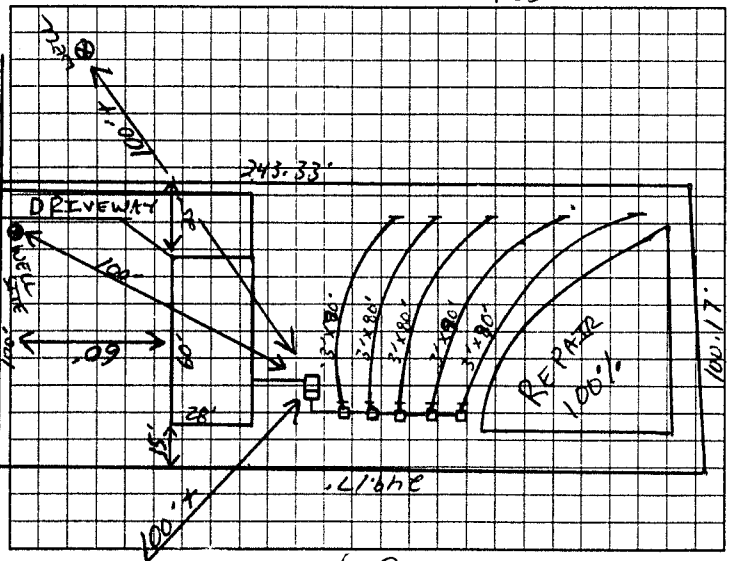

AS BUILT SKETCH

TANK CHANGED 90° / POLYLOK FILTER & MARKER

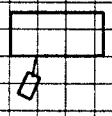

LINES AS DRAWN

Permit can be suspended or revoked if any false information is supplied toward securing the permit/any unauthorized changes are made to the site/any unauthorized changes are made in the installation of the system. Improvement Permit with plat valid without expiration. Improvement Permit with site plan valid for sixty months. Authorization to Construct is valid for a period equal to that of Improvement Permit – not to exceed sixty months.

Signed: RM Hall date 2-6-02 Installed by: A-1 BACKHOE

Improvement Permit by: [signature] RS date 02-04-02 Operation Permit by: [signature] RS date 03-28-02

Authorization to Construct by: [signature] RS date 03-12-02 Existing System Inspection by: _____ date _____

HEALTH DEPT COPY: WHITE OWNER COPY (FINAL): YELLOW OWNER COPY (INITIAL): PINK