# IREDELL COUNTY HEALTH DEPARTMENT

STATESVILLE 704-878-5305 MOORESVILLE 704-664-5281

## IMPROVEMENT PERMIT / AUTHORIZATION TO CONSTRUCT / OPERATION PERMIT / EXISTING SYSTEM INSPECTION

PERMIT# 81445 PIN# 4762 30 3963 DATE 6-11-99

OWNER OR CONTRACTOR Robin Caldwell PHONE: Business – Home 528-4581

ADDRESS 114 Glampy Rd Statesville N.C.

LOCATION 70E TR 8 Bethesda TR Glampy 2nt lot rt.

SUBDIVISION BLOCK / SECTION LOT LOT AREA 1.50 acres SITE CLASS PS DESIGN FLOW 480 L.T.A.R. .35

Septic Tank: 1000 Gallons; STB 786 Date 4-2-99
Pump Tank: Gallons; PT Date
Pump Make: Model Serial No.
Nitrification Field: No Fields 1 Square Feet 1380 Linear Feet 460
No Lines 4 Trench Width 36" Max Trench Bottom Depth 36" Gravel Depth 12"

☐ New System ☐ Repair System Type: I II III IV V VI
System Description: conv. Gravity
Repair System Description: " "
Maintenance Agreement Required: ☐ Yes ☑ No
☐ Slab ☑ Crawl Space ☐ Basement w/plumbing ☐ Basement wo/plumbing


☐ House/Mod. Home No. Bedrooms 4
☑ Mobile Home No. Bathrooms 2
☐ Business No. Employees
☐ Other

Water Supply: ☑ Individual ☐ Public ☐ Community


Comments/Conditions:

Comments/Conditions:
Note: Lines are deep about mid way to the end. Nose slope mix topo - soils good - will have installer cut some

INITIAL SITE SKETCH

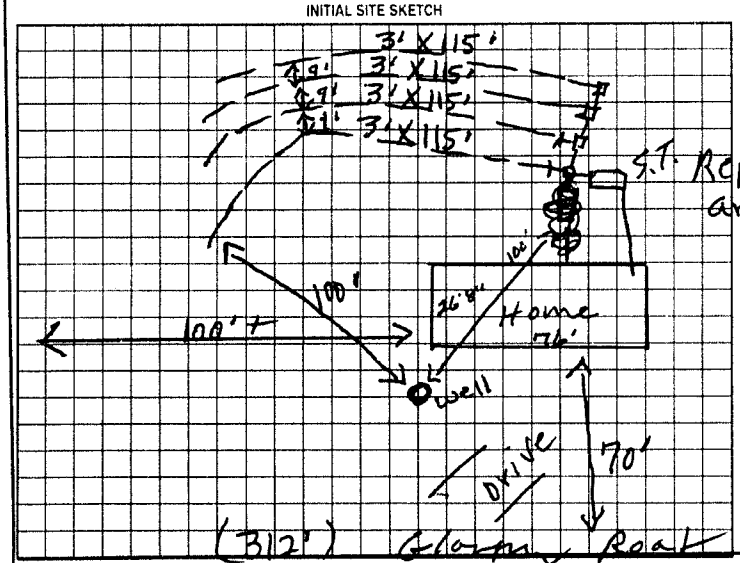


AS BUILT SKETCH

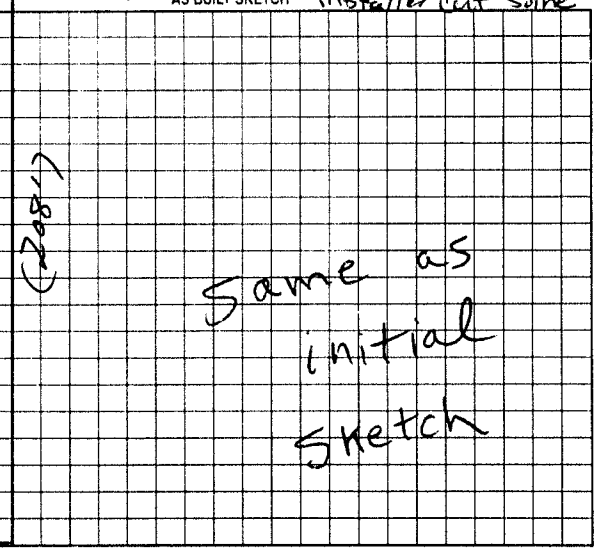


Permit can be suspended or revoked if any false information is supplied toward securing the permit/any unauthorized changes are made to the site/any unauthorized changes are made in the installation of the system. Improvement Permit with plat valid without expiration. Improvement Permit with site plan valid for sixty months. Authorization to Construct is valid for a period equal to that of Improvement Permit – not to exceed sixty months.

Signed: X Robin Caldwell date 6-11-99 Installed by: STB Grading morganton

Improvement Permit by: R.C. Moore date 6-11-99 Operation Permit by: R.C. Moore date 9-10-99

Authorization to Construct by: R.C. Moore date 6-11-99 Existing System Inspection by: date

HEALTH DEPT COPY WHITE OWNER COPY (FINAL) YELLOW OWNER COPY (INITIAL) PINK