IREDELL COUNTY HEALTH DEPARTMENT

STATESVILLE 704-878-5305 MOORESVILLE 704-664-5281

IMPROVEMENT PERMIT / AUTHORIZATION TO CONSTRUCT / OPERATION PERMIT / EXISTING SYSTEM INSPECTION

PERMIT# 102950 PIN# 4762-30-3934 DATE Oct 25, 01

OWNER OR CONTRACTOR Bethesda Road, LLC // Fleetwood Homes PHONE: Business _____ Home _____

ADDRESS P.O. Box 1732 Lincolnton N.C. 28092

LOCATION 70 EAST TR Bethesda Rd. TR Robins Hill Lane on left

SUBDIVISION FAIRWINDS BLOCK / SECTION _____ LOT 16 LOT AREA .5519 Ac SITE CLASS. ES DESIGN FLOW 360gpd L.T.A.R. .3

Septic Tank: 1000 Gallons: STB 1012 Date 4-3-01
Pump Tank: _____ Gallons: PT _____ Date _____
Pump Make: _____ Model _____ Serial No. _____
Nitrification Field: No Fields 1 Square Feet 1200 Linear Feet 400
No Lines 4 Trench Width 36" Max Trench Bottom Depth 36" Gravel Depth 12"

☑ New System ☐ Repair System Type: I, II, III, IV, V, VI
System Description: GRAVITY CONVENTIONAL
Repair System Description: LP INNOVATIVE OR PTBFS
Maintenance Agreement Required: ☐ Yes ☑ No

☐ House/Mod. Home ☑ Mobile Home ☐ Business ☐ Other
No. Bedrooms 3 No. Bathrooms 2 No. Employees ____
☐ Slab ☑ Crawl Space ☐ Basement w/plumbing ☐ Basement wo/plumbing


Water Supply: ☑ Individual ☐ Public ☐ Community

Comments/Conditions:
10-29-01 Reviewed floor plan; in compliance w/ IP sketch/specs.

Comments/Conditions: POLYLOK FILTER & MARKER INSTALLED AS SHOWN

1"=50'

INITIAL SITE SKETCH

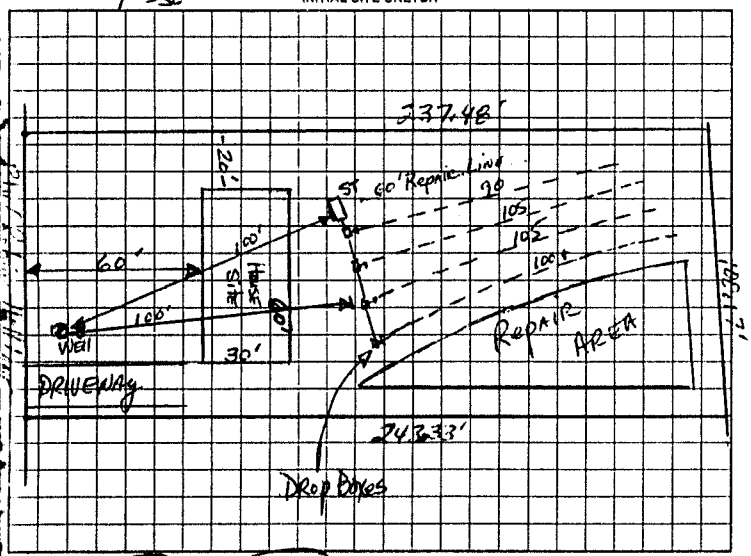

AS BUILT SKETCH

Permit can be suspended or revoked if any false information is supplied toward securing the permit/any unauthorized changes are made to the site/any unauthorized changes are made in the installation of the system. Improvement Permit with plat valid without expiration. Improvement Permit with site plan valid for sixty months. Authorization to Construct is valid for a period equal to that of Improvement Permit – not to exceed sixty months.

Signed: _____ date 10/29/01 Installed by: THOMPSON BACKHOE & GRADING

Improvement Permit by: R Hinson, RS date 10-25-01 Operation Permit by: _____ date 11-1-01

Authorization to Construct by: R Hinson, RS date 10-29-01 Existing System Inspection by: _____ date _____