IREDELL COUNTY HEALTH DEPARTMENT

STATESVILLE 704-878-5305 MOORESVILLE 704-664-5281

IMPROVEMENT PERMIT / AUTHORIZATION TO CONSTRUCT / OPERATION PERMIT / EXISTING SYSTEM INSPECTION

PERMIT# REPAIR PIN# DATE 3-28-01

OWNER OR CONTRACTOR DONALD GLASPY PHONE: Business Home (704) 528-6555

ADDRESS 880 BETHESDA ROAD, STATESVILLE, NC 28677

LOCATION US 70 EAST, TR BETHESDA ROAD, HOUSE ON RIGHT AT BOX #880

SUBDIVISION BLOCK / SECTION LOT LOT AREA LIMITED SITE CLASS PS DESIGN FLOW 360 L.T.A.R. EXISTING

Septic Tank: EXISTING Gallons: STB Date

Pump Tank: Gallons: PT Date

Pump Make: Model Serial No.

Nitrification Field: No Fields 1 Square Feet 240 Linear Feet 80

No Lines ONE Trench Width 36" Max Trench Bottom Depth 36" Gravel Depth 24"

☑ New System ☐ Repair System Type: I (II) III. IV. V. VI

System Description: CONVENTIONAL GRAVITY

Repair System Description: CONVENTIONAL GRAVITY

Maintenance Agreement Required: ☐ Yes ☑ No

☐ Slab ☑ Crawl Space ☐ Basement w/plumbing ☐ Basement wo/plumbing

☐ House/Mod. Home No. Bedrooms 3

☑ Mobile Home No. Bathrooms 2

☐ Business No. Employees

☐ Other


Water Supply: ☑ Individual ☐ Public ☐ Community

WELL

Comments/Conditions: ① INSTALL NEW 3' X 80' DRAINLINE USING 24" STONE ② THIS PERMIT SERVES AS "NOTICE OF VIOLATION" SYSTEM TO BE REPAIRED BY 4-28-2001

Comments/Conditions:

INITIAL SITE SKETCH

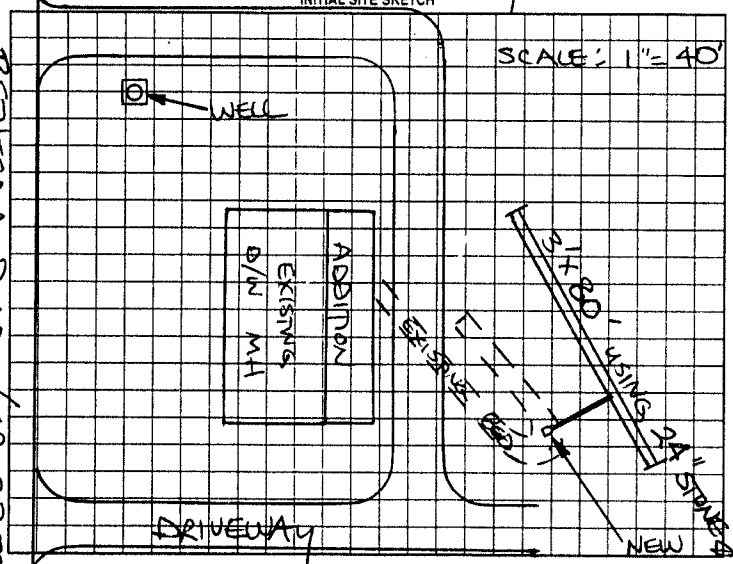

AS BUILT SKETCH

SYSTEM REPAIRED ACCORDING TO INITIAL SITE SKETCH

BETHESDA ROAD (SR 2359)

Permit can be suspended or revoked if any false information is supplied toward securing the permit/any unauthorized changes are made to the site/any unauthorized changes are made in the installation of the system. Improvement Permit with plat valid without expiration. Improvement Permit with site plan valid for sixty months. Authorization to Construct is valid for a period equal to that of Improvement Permit – not to exceed sixty months.

Signed: Donald Glaspy date 3/28/01 Installed by: UPRIGHT GRADING

Improvement Permit by: STEVE HEDRICK date 3-28-01 Operation Permit by: STEVE HEDRICK date 4-2-01

Authorization to Construct by: STEVE HEDRICK date 3-28-01 Existing System Inspection by: date

HEALTH DEPT. COPY: WHITE OWNER COPY (FINAL): YELLOW OWNER COPY (INITIAL): PINK