ICHD - ENVIRONMENTAL HEALTH DIVISION

Statesville Office (704) 878-5305 Mooresville Office (704) 660-3625 PERMIT # 312099

BB 3:30

SEPTIC: IMPROVEMENT PERMIT / AUTHORIZATION TO CONSTRUCT / OPERATION PERMIT / EXISTING SYSTEM

PIN # 4762 - 30 - 6222

APPLICANT/OWNER: Stephen Wellman APPLICANT ADDRESS: 118 Marlake Dr Mooresville 28117

SITE ADDRESS: 892 Bethesda Rd Statesville NC 28677 PHONE: 704-431-9584 ALT. PHONE —

SITE DIRECTIONS: Hwy 70 R on Bethesda House on R SAP CONTROLLED: ☐ YES ☐ NO


SUBDIVISION: — SECTION: — LOT # — LOT AREA: 1 DESIGN FLOW: Ex L.T.A.R.: Ex

Septic Tank	1000 (gal)	STB	760	Date	9-26	☐ New System	☒ Repair	☐ Expansion	System Type: I (II) III IV V VI	☒ Residence	No. Bedrooms Ex
Pump Tank	(gal)	PT		Date		System Description:				☐ Business	No. Persons Ex
Pump Make		Model		Serial #		Repair System Description:	Tank			☐ Other	No. Employees
# Nitrification Fields	Ex # Lines			Linear Ft:	NA	Maintenance Agreement Required:	☐ YES	☒ NO		☐ Slab	☐ Crawl Space
Trench Width	Trench Bottom Depth(Low side)			Gravel Depth	Ex		☒ GRAVITY	☐ PRESSURE		☒ Basement w/plumbing	☐ Basement w/o plumbing

Water Supply: ☐ Private ☒ Public ☐ Community

Comments / Conditions: Pump Crush and fill old ST. Inspect D Box and replace if needed.

INITIAL SITE SKETCH

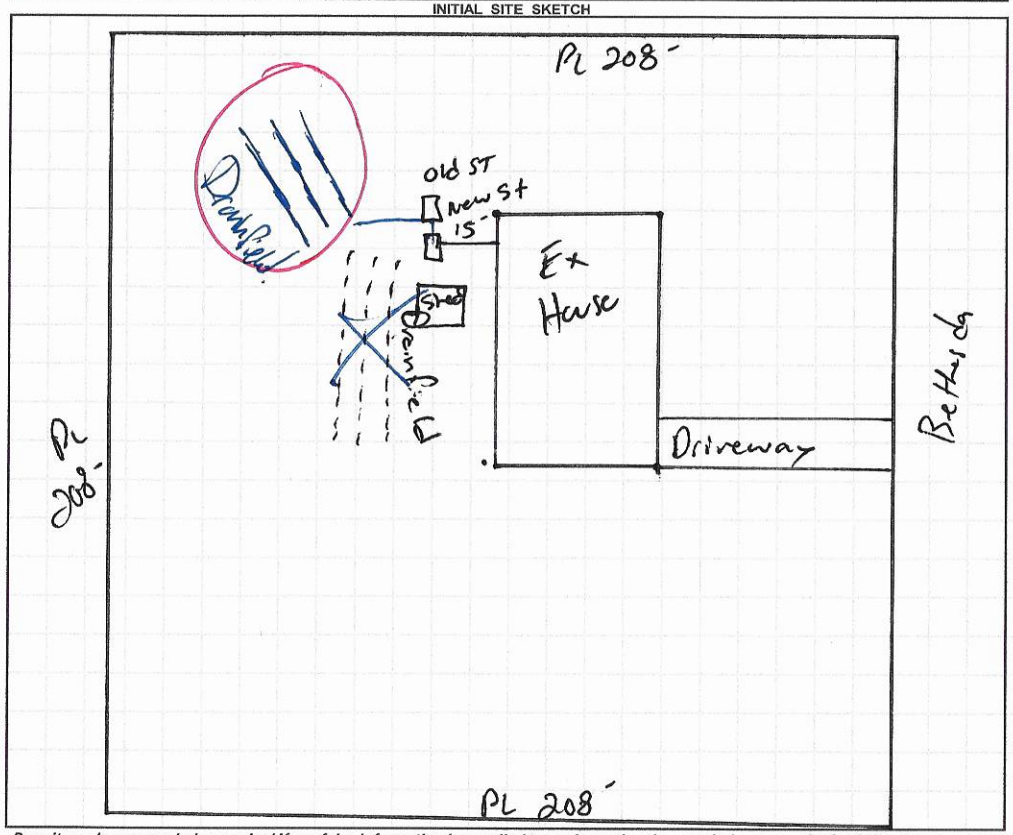

AS BUILT SKETCH

FOR SEPTIC FINAL INSPECTION CALL: 704-664-3703 between 8am-9am the day the inspection is needed. Be sure to speak with an inspector to confirm your time.

1E50'

Installed as shown.
Drainfield Location.
To checked.

Permit can be suspended or revoked if any false information is supplied toward securing the permit / any unauthorized changes are made to the site / any unauthorized changes are made in the installation of the system. **CONTACT A LOCATOR SERVICE PRIOR TO ANY EXCAVATION**

☐ **IMPROVEMENT PERMIT** *with plat valid without expiration* ☒ **IMPROVEMENT PERMIT** *with site plan valid for 60 mos.* ☒ **AUTHORIZATION TO CONSTRUCT** *valid for period equal to IMPROVEMENT PERMIT--not to exceed 60 mo.*

Owner / Applicant Signature: Stephen Wellman Date: 11/2/2020 Installed by: Lentz Wastewater

IMPROVEMENT PERMIT by: Date: 10-30-2020 OPERATION PERMIT by: Benjamin A Bottles Date: 11/23/2020

AUTHORIZATION TO CONSTRUCT by: Date: 10-30-2020 Existing System Inspected by: Date:

FOR SEPTIC FINAL INSPECTION: CALL 704-664-3703 between 8am-9am the day the inspection is needed.

DocuSign Envelope ID: E292943B-3155-44DB-A193-E5419C6CFAD9

RECEIVED OCT 2 3 2020

APPLICATION MUST BE FILLED OUT COMPLETELY & BE LEGIBLE OR IT WILL NOT BE PROCESSED

AP- 312099

Iredell County Health Department – Environmental Health Division

PAGE 1: *APPLICATION FORM*

Repair Evaluation

Application For: ( ) New Well Permit (X) Well Repair Permit ( ) Well Abandonment
( ) Septic Improvement Permit ( ) Authorization to Construct (X) Existing System Inspection ( ) Septic System Repair

THE ABOVE PERMIT DOCUMENTS WILL BECOME INVALID IF INFORMATION PROVIDED ON THIS APPLICATION IS FALSIFIED OR CHANGED, OR IF THE SITE IS ALTERED. THE IMPROVEMENT PERMIT IS VALID FOR EITHER 60 MONTHS OR WITHOUT EXPIRATION DEPENDING UPON DOCUMENTATION SUBMITTED. APPLICATION WITH SITE PLAN 60 MONTHS, APPLICATION WITH COMPLETE, SCALED PLAT WITHOUT EXPIRATION. SEE 15A NCAC 18A .1937(f) FOR DETAILS.

Page 2: *Site Plan Worksheet* form MUST accompany this application

The following optional attachments may also be submitted: ( ) Survey Plat, scaled no more than 1 inch = 60 feet
Place an (X) beside whichever is submitted if applicable ( ) Custom Site Plan, scaled no more than 1 inch = 60 feet

Applicant Information: (PRINT CLEARLY)

Applicant Name: Stephen Wellman Address: 118 Mordake Dr Mooresville Zip: 28117
Applicant Email: stephen.wellman@kw.com Phone: 704-431-9584 Alt. Phone: _____
Owner Name: Penny Little Richard Heggan Address: 892 Bethesda Rd Zip: 28677
Owner Email: pheaggans1little@gmail.com Phone: 704-402-8120 Alt. Phone: _____

Property Information:

Street Address: 892 Bethesda Rd Statesville, NC 28677
Subdivision Name: _____ Section/Phase: _____ Lot Number: _____
Driving Directions: (L) on E. Garner Bagnal Blvd (R) Bethesda Rd house on (R) ≈ 5 miles

Site Development Information: *(check or complete ALL that apply*

CHECK FOUNDATION TYPE

( ) New Single Family Residence
( ) New Multi-Family Residence
( ) Accessory Building
( ) Bedroom(s) Addition
(X) Repair to failing septic system ✓ Tank ___ Drain lines Describe Problem: see attached
Maximum Number of Bedrooms: 3
Maximum Number of Occupants: 6
( ) Swimming Pool
( ) Other Addition/Structure: _____
( ) Crawl Space Foundation
( ) Concrete Slab Foundation
(X) Basement with Plumbing
( ) Basement without Plumbing

Non-Residential Site Development: Type of Business: _____
Square Footage of Building: _____ Max. Number of Employees: _____ Max. Number of Seats/Beds/Other: _____

Water Supply: ( ) Replacement Well – Reason: _____
( ) Multi-connection Well Number of Houses: _____ Number of Persons: _____
( ) New Well ( ) Existing Well ( ) Community Well ( ) City Water (X) Other Public Water

Desired Septic System Type: *(you may rank in order of preference)* Year existing system installed: _____
(X) No Preference ( ) Alternative ( ) Conventional ( ) Innovative ( ) Modified Conventional ( ) Other: _____

Please answer the following to the best of your ability:

( ) Yes (X) No Does the site contain any jurisdictional wetlands?
( ) Yes (X) No Is any non-domestic sewage (i.e. industrial) to be generated?
( ) Yes (X) No Is the site subject to approval by any other public agency?

No permit in DB

I have read this application and certify that the information provided herein is true, complete, and correct. Authorized county and state officials are granted right of entry to conduct necessary inspections to determine compliance with applicable laws and rules. I understand that I am solely responsible for the proper identification and labeling of all property lines and corners and making the site accessible so that a complete site evaluation can be performed.

Signature: DocuSigned by: Penny Little 5888B8F9B4B1... rty owner or owner's l — DocuSigned by: Richard Heggan C927 presentative signature — DATE SIGNATURE REQUIRED — 10/22/2020 | 5:19 AM PDT 10/23/2020 | 4:18 PM EDT — DATE


DocuSign Envelope ID: E292943B-3155-44DB-A193-E5419C6CFAD9

IREDELL COUNTY HEALTH DEPARTMENT

ENVIRONMENTAL HEALTH DIVISION

PAGE 2: *SITE PLAN WORKSHEET*

SEE THE "SAMPLE SITE PLAN" BELOW. *INCOMPLETE SITE PLANS WILL BE RETURNED TO YOU FOR COMPLETION AND MAY RESULT IN A DELAY IN THE ISSUANCE OF YOUR SEPTIC SYSTEM PERMIT*!!!

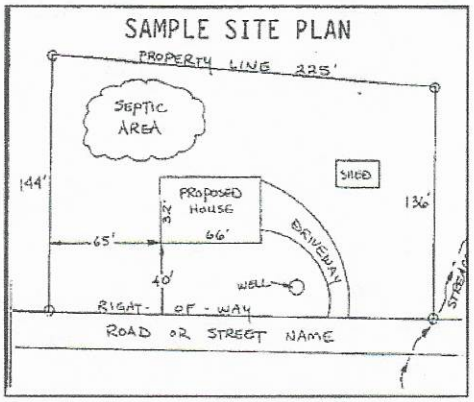

Place an (X) beside each item as you complete the site plan:


- ( ) Property Line measurements are clearly identified
- ( ) All proposed structures are indicated
- ( ) Front and side setbacks from property line
- ( ) Preferred driveway location and well location
- ( ) Area you prefer your septic system to be placed
- ( ) North arrow, or other sufficient indicator of direction

Circle N/A on the following if appropriate:

Location of septic systems and wells within 100' of your property	N/A
Location of easements and rights of ways on your property	N/A
Location of any designated wetlands on the property	N/A

USE THIS SPACE TO DRAW YOUR SITE PLAN

Show: proposed house or business footprint, wells, water lines, patios, pools and decks, and any other item that will occupy space on the site

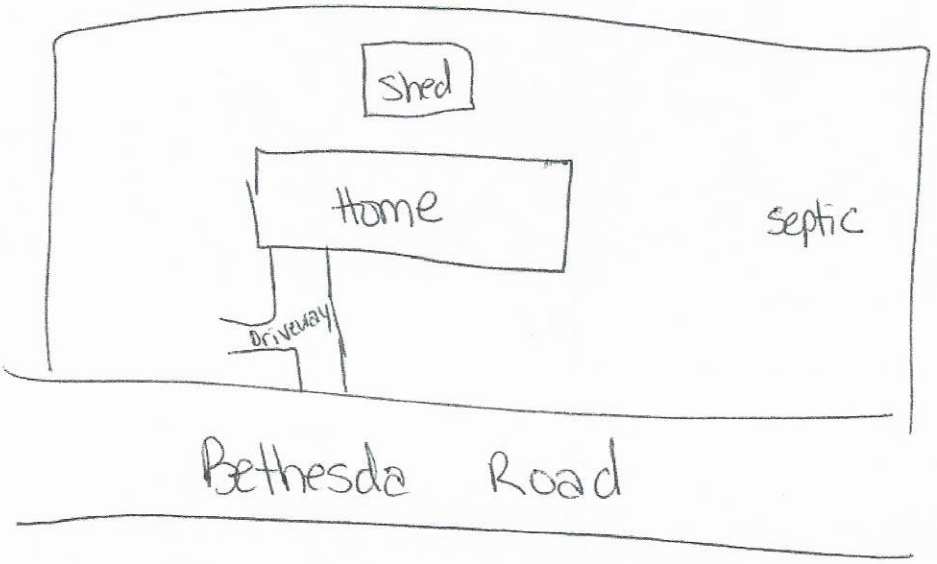

Signature: DocuSigned by: Penny Little 628536BD6F064D1... DocuSigned by: Richard Hargrove C027705B71CD486... 10/22/2020 | 5:29 AM EDT 10/21/2020 | 4:

Property owner or owner's legal representative signature (SIGNATURE REQUIRED) **DATE**

DocuSign Envelope ID: E292943B-3155-44DB-A193-E5419C6CFAD9

Public Health
Prevent. Promote. Protect.
Iredell County Health Department

IREDELL COUNTY DEPARTMENT OF ENVIRONMENTAL HEALTH

Public Health
Prevent. Promote. Protect.
Iredell County Health Department

DOCUMENTATION TO AUTHORIZE AN OWNER'S LEGAL REPRESENTATIVE

(Check and sign only ONE of the options below)

☐ **1. * APPLICANT AND OWNER ARE THE SAME. *** (*Sign here*) _____

Applications for permits require the "signature of the owner or owner's legal representative" (15A NCAC 18A .1937). If the owner does not sign the application himself or herself, they can submit any one of the following documents to designate their legal representative: *Power of Attorney; Real Estate Contract; Estate executor; Bankruptcy trustee; Court ordered guardianship*
In the absence of the above documentation, the property owner may provide the local health department with documentation that designates a legal representative. A property owner may:
Complete this form to document his or her legal representative, or provide his or her own form that contains the information in this form. If there are multiple property owners, then all property owners must sign the form that designates a legal representative.
By signing a form that designates a legal representative for purposes of 15A NCAC 18A .1937, the property owner authorizes that representative to act on their behalf in matters pertaining to the application and permitting process, including signing or receiving any application, document or permit. The owner retains full responsibility to meet all permit conditions specified by the local health department.

☒ **2.** I, Penny Little & Richard Hargsons am the legal owner(s) of the property located at 892 Bethesda Rd, identified as PIN (Parcel Identification Number) 4702306222.000, located in Iredell County, North Carolina.

I do hereby authorize (**print legal representative/company name**) Stephen Wellman, Keller Williams Mooresville, to act as an agent on my behalf in applying for/signing/obtaining any of the documents described below.

- Application for Improvement Permit (IP) / Authorization to Construct (AC)
- Improvement Permit (IP) / Authorization to Construct (AC)
- Application for soil-site evaluation (new/repair)
- Application/permit for private drinking water well/well abandonment
- Application for Compliance Inspection

I agree to abide by all decisions and/or conditions between the legal representative acting on my behalf and the Iredell County Department of Public Health, Environmental Health Division.

DocuSigned by: Penny Little 8285368D6F964D1... — DocuSigned by: Richard Hargsons C927705B71CD465... — Signature of Owner(s)

10/22/2020 | 5:29 AM PDT 10/21/2020 | 4:18 PM PDT — Date

Mooresville - Environmental Health

Fax: 704-662-3239
610 E. Center Avenue, Mooresville, NC 28115

Statesville - Environmental Health
ronda.hart@co.iredell.nc.us
Fax: 704-871-3483
349 N. Center Street, Statesville, NC 28677