IREDELL COUNTY HEALTH DEPARTMENT

STATESVILLE 704-878-5305 MOORESVILLE 704-664-5281

IMPROVEMENT PERMIT / AUTHORIZATION TO CONSTRUCT / OPERATION PERMIT / EXISTING SYSTEM INSPECTION

PERMIT# 84006 PIN# 4762 21 7515 DATE 10-14-99

OWNER OR CONTRACTOR Piedmont Housing PHONE: Business 528 7120 Home

ADDRESS 1040 Charlotte Hwy Troutman N.C.

LOCATION NO E TR Bethesda Rd past Bethesda Church 1/8 mi Rt

SUBDIVISION Fairwinds BLOCK / SECTION 1 LOT 13 LOT AREA .46 acres SITE CLASS PS DESIGN FLOW 360 L.T.A.R. 133

Septic Tank: 1000 Gallons; STB 714 Date 1.10.01

Pump Tank: Gallons; PT Date

Pump Make: Model Serial No. 360

Nitrification Field: No Fields 1 Square Feet 1080 Linear Feet

No Lines 4 Trench Width 36" Max Trench Bottom Depth 36" Gravel Depth 12"

☐ New System ☐ Repair System Type: I, II, III, IV, V, VI

System Description: Conv. Gravity

Repair System Description: Gravity 25% Red

Maintenance Agreement Required: ☐ Yes ☐ No

☐ House/Mod. Home ☐ Mobile Home ☐ Business ☐ Other

No. Bedrooms 3 No. Bathrooms 2 No. Employees


Water Supply: ☒ Individual ☐ Public ☐ Community

☐ Slab ☐ Crawl Space ☐ Basement w/plumbing ☐ Basement wo/plumbing

Comments:/Conditions:

Comments:/Conditions: SYSTEM INSTALLED AS SHOWN WITH POLY LOK FILTER & MARKER. Second Box outlet hole cutout and patched with sealrope.

INITIAL SITE SKETCH

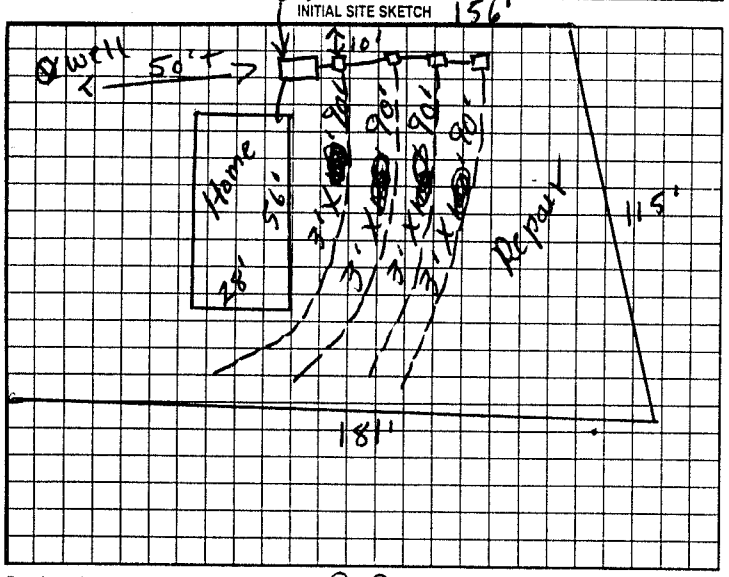

AS BUILT SKETCH

Bethesda 105

Permit can be suspended or revoked if any false information is supplied toward securing the permit/any unauthorized changes are made to the site/any unauthorized changes are made in the installation of the system. Improvement Permit with plat valid without expiration. Improvement Permit with site plan valid for sixty months. Authorization to Construct is valid for a period equal to that of Improvement Permit – not to exceed sixty months.

Signed: RM date 10-15-99 Installed by: Craig Thompson

Improvement Permit by: R.C. Moore date 10-14-99 Operation Permit by: Tim Cook PSI date 03-12-01

Authorization to Construct by: R.C. Moore date 10-14-99 Existing System Inspection by: date

HEALTH DEPT. COPY: WHITE OWNER COPY (FINAL): YELLOW OWNER COPY (INITIAL): PINK