5

BF

IREDELL COUNTY HEALTH DEPARTMENT

Statesville Office (704) 878-5305 Mooresville Office (704) 660-3625 PERMIT # 209841

IMPROVEMENT PERMIT / AUTHORIZATION TO CONSTRUCT / OPERATION PERMIT / EXISTING SYSTEM

PIN # 4762-30-8097.000

APPLICANT: Michael Ryan Homes Inc. APPLICANT ADDRESS: 10700 Mallard Creek Rd. #102 Charlotte NC 28262

SITE ADDRESS: 157 Mountain Island Dr. Statesville NC PHONE: 704-504-9000 ALT. PHONE: # 980-216-0652 #

SITE DIRECTIONS: Hwy 70, TR Bethesda, TL Northlake, TL Mountain Island. Site on L @ End.


SUBDIVISION: Northlake SECTION. 2 LOT # 7 LOT AREA: .530 Acre DESIGN FLOW: 360 GPD L.T.A.R.: .3

Septic Tank	1000	(gal)	STB 794	Date	11/15/15	☒ New System	☐ Repair	☐ Expansion	System Type: I II III IV V VI	☒ Residence	No. Bedrooms 3
Pump Tank		(gal)	PT	Date		System Description:	25% Reduction - Gravity			☐ Business	No. Persons 6
Pump Make		Model		Serial #		Repair System Description:	LP-PPBPS			☐ Other	No. Employees
# Nitrification Fields	1	# Lines	4	Linear Ft:	300'	Maintenance Agreement Required:	☐ YES	☒ NO		☒ Slab	☐ Crawl Space
Trench Width	36"	Max. Trench Bottom Depth	36"	Gravel Depth	N/A		☒ GRAVITY	☐ PRESSURE		☐ Basement w/plumbing	☐ Basement w/o plumbing


Water Supply: ☐ Private ☒ Public ☐ Community

Comments / Conditions: Install As Drawn. Follow All NC State Rules.

INITIAL SITE SKETCH

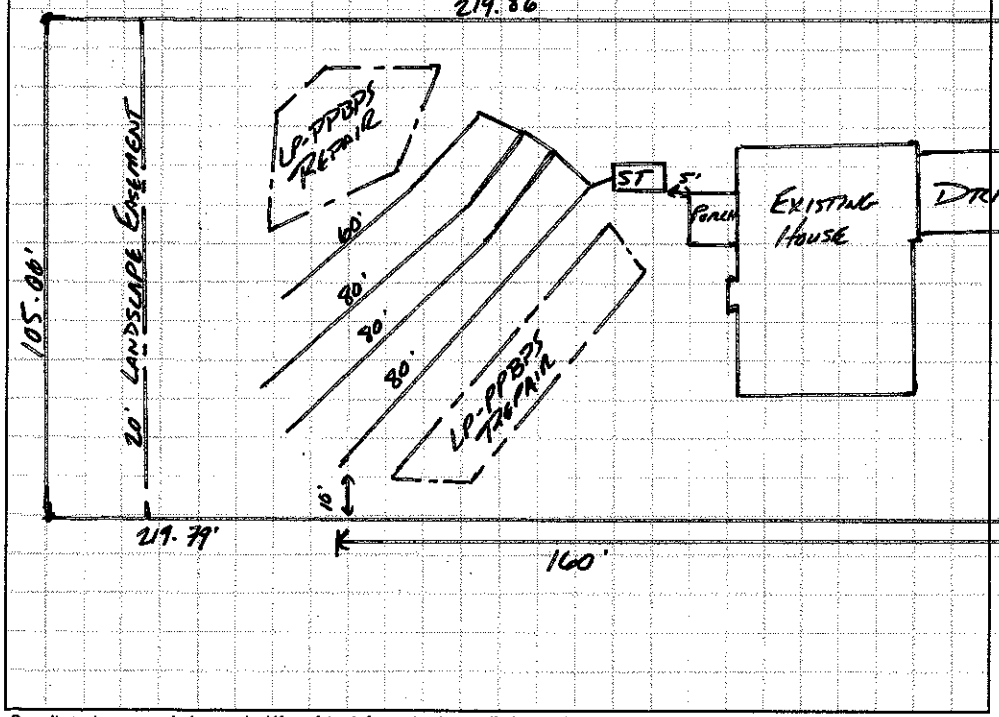

AS BUILT SKETCH

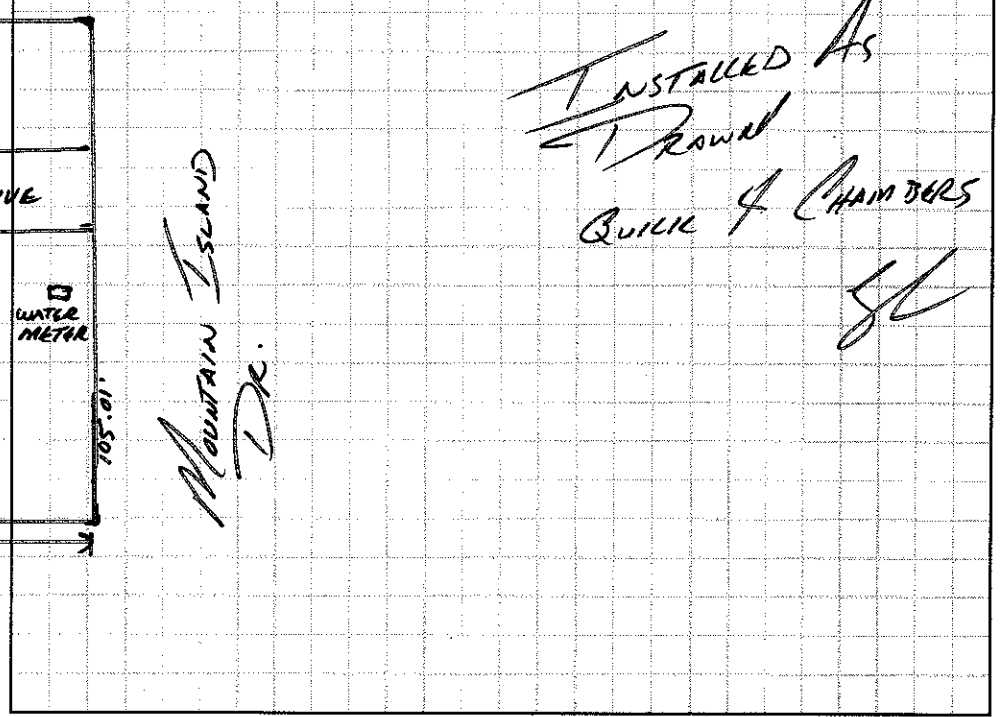

Permit can be suspended or revoked if any false information is supplied toward securing the permit / any unauthorized changes are made to the site / any unauthorized changes are made in the installation of the system. **CONTACT A LOCATOR SERVICE PRIOR TO ANY EXCAVATION**

☐ **IMPROVEMENT PERMIT** *with plat valid without expiration* ☒ **IMPROVEMENT PERMIT** *with site plan valid for 60 mos.* ☒ **AUTHORIZATION TO CONSTRUCT** *valid for period equal to IMPROVEMENT PERMIT--not to exceed 60 mo.*

Owner / Applicant Signature: Date: 12/22/15 Installed by: Marty Tucker

IMPROVEMENT PERMIT by: Date: 12/17/15 OPERATION PERMIT by: Date: 1/6/16

AUTHORIZATION TO CONSTRUCT by: Date: 12/18/15 Existing System Inspected by: Date:

Health Dept. Copy - WHITE Applicant (Final Approval) - YELLOW Applicant (Conditional Approval) - PINK