Site; 163 Mountain Island Dr.

IREDELL COUNTY HEALTH DEPARTMENT

STATESVILLE 704-878-5305 MOORESVILLE 704-664-5281

20983

IMPROVEMENT PERMIT / AUTHORIZATION TO CONSTRUCT / OPERATION PERMIT / EXISTING SYSTEM INSPECTION

PERMIT # 132943 PIN # 4762309118 DATE 19 Dec 08

OWNER or APPLICANT ABMS Development LLC PHONE: Business 704-664-7029 Home:

OWNER or APPLICANT ADDRESS 145 Falmouth RD Mooresville NC 28117

LOCATION / DIRECTIONS Oswalt Amity @ Bethesda @ Northlake

SUBDIVISION Northlake BLOCK / SECTION LOT # 9 LOT AREA .63 DESIGN FLOW 480 L.T.A.R. .3

Septic Tank 1000 Gallons: STB 794 Date 11/30/15

Pump Tank Gallons: P T Date

Pump Make Model Serial #

Nitrification Field No Fields No Lines Linear Feet 400

Trench Width 36" Max. Trench Bottom Depth 36" Gravel Depth

☑ New System ☐ Repair ☐ Expansion System Type I II III IV V VI

System Description: 2570 Gravity

Repair System Description: 5010 Low Pressure

Maintenance Agreement Required ☐ YES ☒ NO

☒ GRAVITY ☐ PRESSURE

☒ Residence No. Bedrooms 4

☐ Business No. Persons 8

☐ Other No. Employees

☒ Slab Crawl Space

☐ Basement w/plumbing ☐ Basement w/o plumbing

Water Supply: ☐ Private ☒ Public ☐ Community


Comments / Conditions

Comments / Conditions

INITIAL SITE SKETCH

(See attached Drawing by's Rollins Soil & Environmental Soil Svc, Inc)

AS BUILT SKETCH

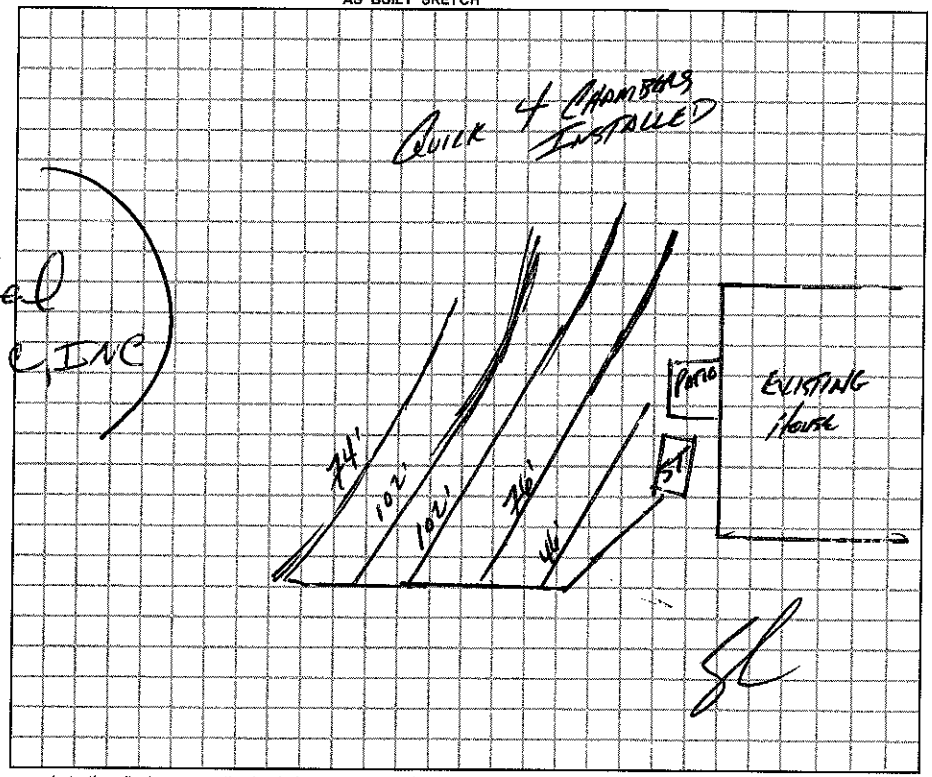

Permit can be suspended or revoked if any false information is supplied toward securing the permit / any unauthorized changes are made to the site / any unauthorized changes are made in the installation of the system.

☐ *IMPROVEMENT PERMIT w / plat valid without expiration* ☐ *IMPROVEMENT PERMIT w / site plan valid for 60 mos.* ☒ *AUTHORIZATION TO CONSTRUCT valid for period equal to IMPROVEMENT PERMIT-not to exceed 60 mo.*

Owner / Applicant Signature: Date 2/9/09

Improvement Permit by: Date 19 Dec 08

Authorization to Construct by: Date 5/20/15


Installed by: Marty Tucker

Operation Permit by: Date: 1/7/16

Existing System Inspected by: Date:

YOU SHOULD CONTACT A LOCATOR SERVICE PRIOR TO ANY EXCAVATION.

WHITE COPY Environmental Health YELLOW COPY (Final) Owner / Applicant PINK COPY (Initial) Owner / Applicant

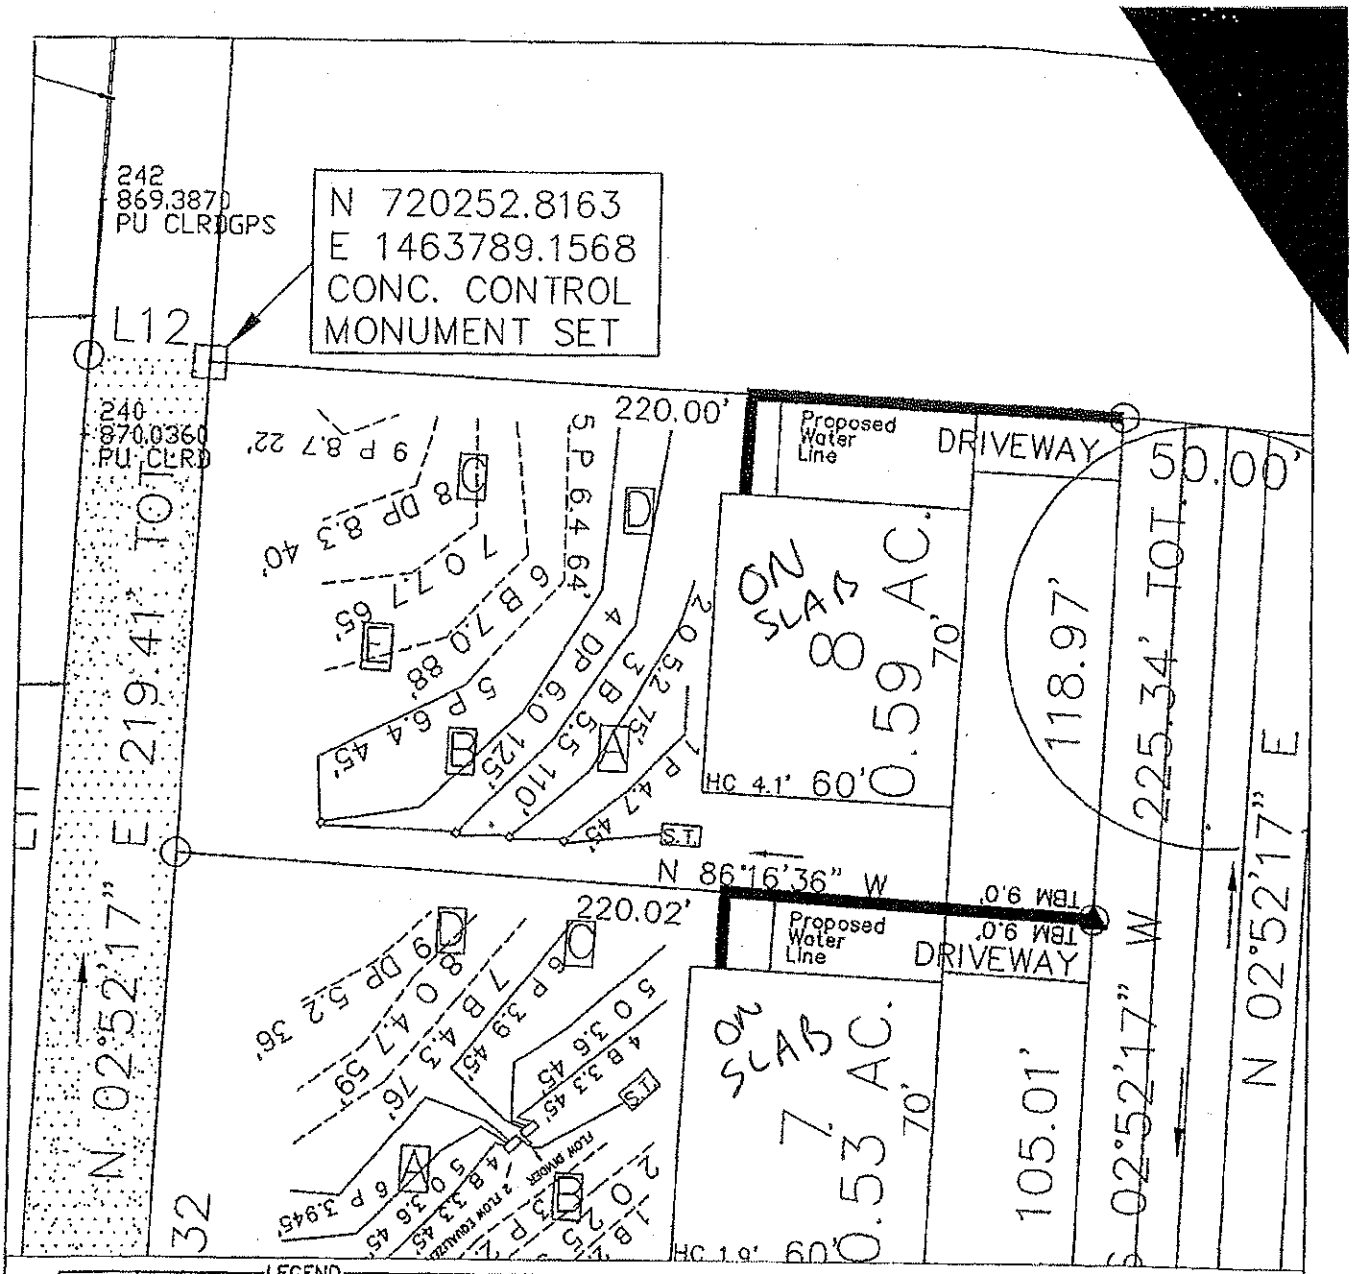

ROLLANS SOIL & ENVIRONMENTAL SERVICES
170 NORTH BROAD STREET SUITE D
MOORESVILLE, NC 28115
PHONE: (704) 658-1723
FAX: (704) 658-1724

MAP TITLE: SITE PLAN & DRAINFIELD AREAS
PROJECT NAME: NORTHLAKE SUBDIVISION
LOCATION/DATE: IREDELL COUNTY, NORTH CAROLINA JULY 2008
JOB # : 01-1391
FILE: C:\JOBS\01-1391
PROJECT MGR: A.L.P.
FIELD WORK: A.L.P.
DRAWN BY: A.L.P.

163