IREDELL COUNTY HEALTH DEPARTMENT

STATESVILLE 704-878-5305 (21) MOORESVILLE 704-664-5281

IMPROVEMENT PERMIT / AUTHORIZATION TO CONSTRUCT / OPERATION PERMIT / EXISTING SYSTEM INSPECTION

PERMIT# 104805 PIN# 4762-31-0553 DATE 11-15-04

OWNER OR CONTRACTOR BETHESDA ROAD, LLC PHONE: Business 704-736-4331 Home

ADDRESS P.O. BOX 1732, LINCOLNTON, NC 28092

LOCATION US 70 EAST, TR BETHESDA ROAD, TR FAIRWIND LANE, 4TH LOT ON LEFT

SUBDIVISION FAIRWINDS BLOCK / SECTION I LOT 30 LOT AREA 0.67 ACRE SITE CLASS. PS DESIGN FLOW 480 L.T.A.R. 0.25 GPD/FT2

Septic Tank: 1000 Gallons; STB 1012 Date 6-20-04
Pump Tank: ____ Gallons; PT ____ Date ____
Pump Make: ____ Model ____ Serial No. ____
Nitrification Field: No Fields 1 Square Feet EQ TO 1920 Linear Feet 360
No Lines EIGHT Trench Width 24 Max Trench Bottom Depth 36"

☑ New System ☐ Repair System Type: I, II, III, IV, V, VI
System Description: 50% REDUCTION, GRAVITY
Repair System Description 50% REDUCTION LOW
Maintenance Agreement Required: ☐ Yes ☑ No PRESSURE ☐ Other
~~Gravel~~ Depth 24" SAND ☐ Slab ☑ Crawl Space ☐ Basement w/plumbing ☐ Basement wo/plumbing


☑ House/Mod. Home No. Bedrooms 4
☐ Mobile Home No. Bathrooms ____
☐ Business No. Employees ____

Water Supply:
☑ Individual
☐ Public
☐ Community
WELL


Comments:/Conditions: ① INSTALL 50% REDUCTION SYSTEM ON CONTOUR AS SHOWN USING 80 PPBPS PANELS
② KEEP SYSTEM MAXIMUM FEASIBLE DISTANCE FROM WELL

Comments:/Conditions: SEPTIC TANK WITH MARKER INSTALLED USING "ZABEL" FILTER

INITIAL SITE SKETCH

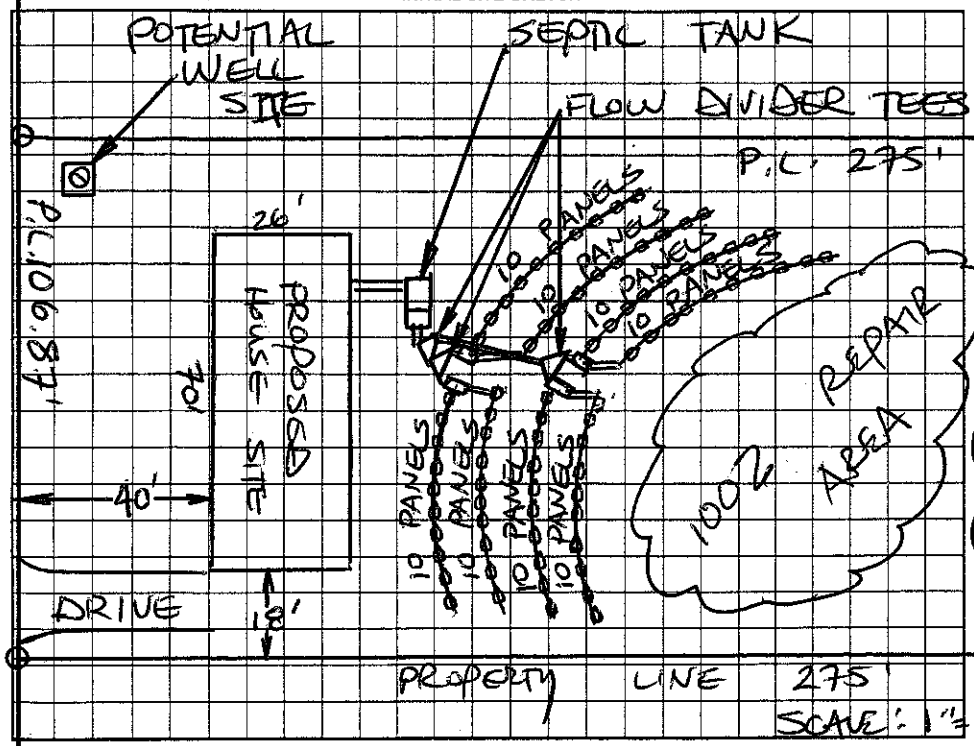

AS BUILT SKETCH

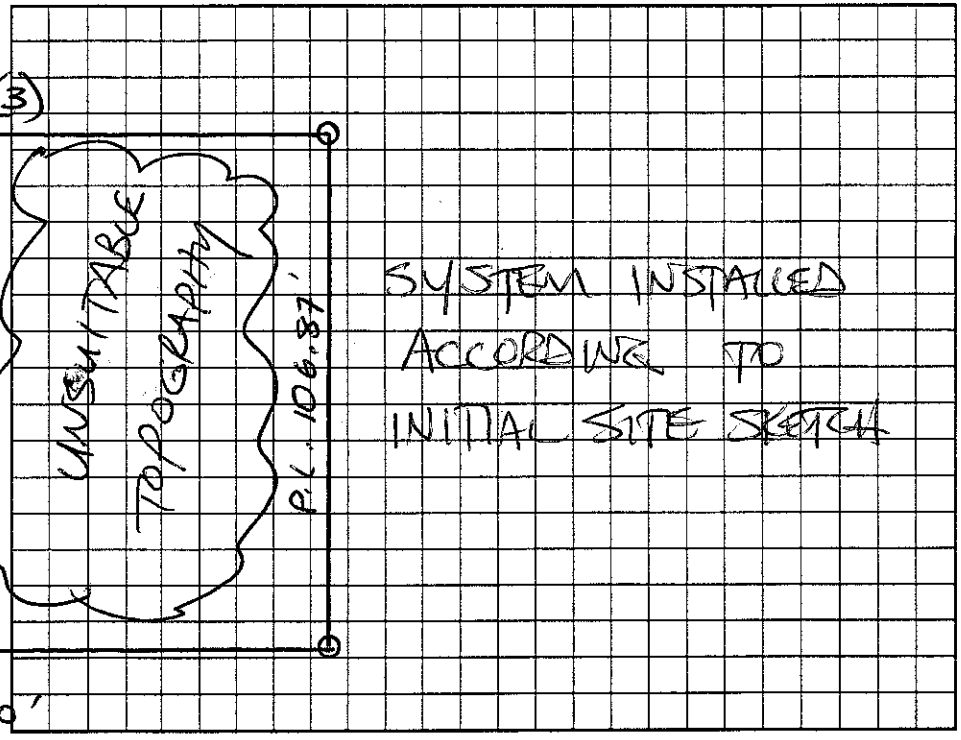

FAIRWIND LANE

Permit can be suspended or revoked if any false information is supplied toward securing the permit/any unauthorized changes are made to the site/any unauthorized changes are made in the installation of the system. Improvement Permit with plat valid without expiration. Improvement Permit with site plan valid for sixty months. Authorization to Construct is valid for a period equal to that of Improvement Permit – not to exceed sixty months.

Signed: Dennis Dellinger date 16 NOV

Improvement Permit by: STEVE HEDRICK date 11-15-04

Authorization to Construct by: STEVE HEDRICK date 11-15-04

Installed by: A-1 BACKHOE

Operation Permit by: STEVE HEDRICK date 11-22-04

Existing System Inspection by: ____ date ____

HEALTH DEPT. COPY: WHITE OWNER COPY (FINAL): YELLOW OWNER COPY (INITIAL): PINK