IREDELL COUNTY HEALTH DEPARTMENT

STATESVILLE 704-878-5305 MOORESVILLE 704-664-5281

IMPROVEMENT PERMIT / AUTHORIZATION TO CONSTRUCT / OPERATION PERMIT / EXISTING SYSTEM INSPECTION

(LI)

PERMIT# 107721 PIN# 4762-31-1245 DATE 8-12-02

OWNER OR CONTRACTOR FLEETWOOD HOMES OF STVL. PHONE: Business 704-872-0179 Home

ADDRESS 1270 NORTHSIDE DRIVE STATESVILLE NC 28677

LOCATION US 70 EAST, TR BETHESDA ROAD, TR ROBINS HILL LANE, LOT AT END ON RIGHT

SUBDIVISION FAIRWINDS BLOCK / SECTION LOT 22 LOT AREA 0.7035 ACRE SITE CLASS PS DESIGN FLOW 480 L.T.A.R. 0.40 GPD/FT²

Septic Tank: 1000 Gallons: STB 1012 Date 08/21/02
Pump Tank: Gallons: PT Date
Pump Make: Model Serial No
Nitrification Field: No Fields 1 Square Feet 1200 Linear Feet 400
No Lines FIVE Trench Width 36" Max Trench Bottom Depth 36" Gravel Depth 12"

☑ New System ☐ Repair System Type: I II III IV V VI
System Description: CONVENTIONAL GRAVITY
Repair System Description: CONVENTIONAL GRAVITY
Maintenance Agreement Required: ☐ Yes ☑ No
☐ Slab ☑ Crawl Space ☐ Basement w/plumbing ☐ Basement wo/plumbing


☐ House/Mod. Home No. Bedrooms 4
☑ Mobile Home No. Bathrooms 2
☐ Business No. Employees
☐ Other

Water Supply: ☑ Individual ☐ Public ☐ Community WELL


Comments/Conditions: KEEP SYSTEM MINIMUM 100 FEET FROM WELL

Comments/Conditions: SEPTIC TANK INSTALLED USING POLY-LOC FILTER + MARKER

INITIAL SITE SKETCH

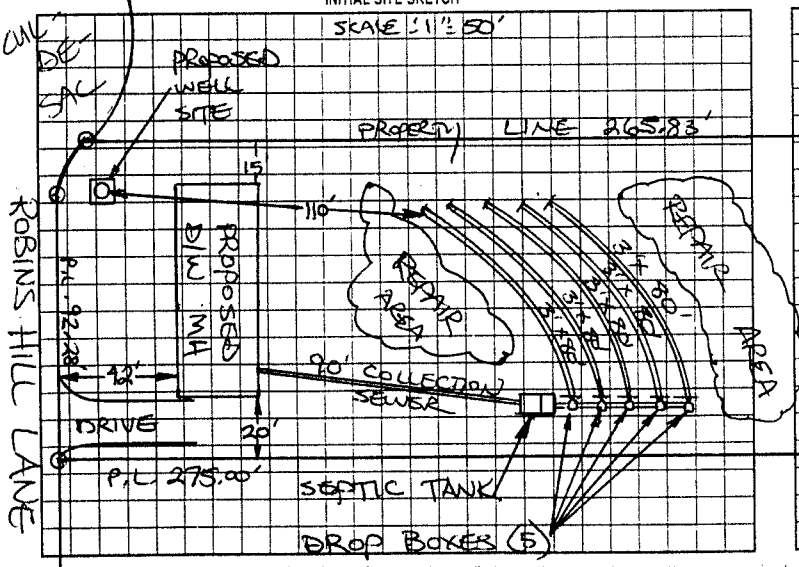

AS BUILT SKETCH

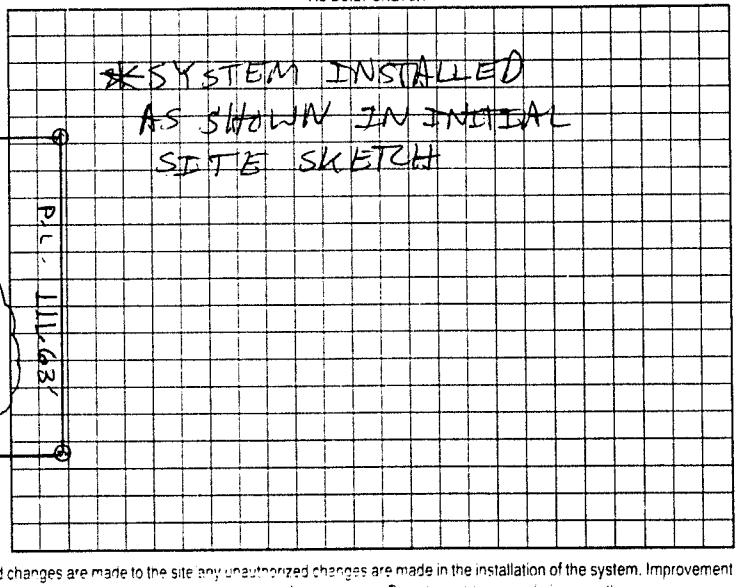

Permit can be suspended or revoked if any false information is supplied toward securing the permit/any unauthorized changes are made to the site any unauthorized changes are made in the installation of the system. Improvement Permit with plat valid without expiration. Improvement Permit with site plan valid for sixty months. Authorization to Construct is valid for a period equal to that of Improvement Permit - not to exceed sixty months

Signed: [signature] date 8-12-02 Installed by: CRAIG THOMSON GRADING

Improvement Permit by: STEVE HENDRICK date 8-12-02 Operation Permit by: [signature] date 08/21/02

Authorization to Construct by: STEVE HENDRICK date 8-12-02 Existing System Inspection by: date

HEALTH DEPT COPY: WHITE OWNER COPY (FINAL) YELLOW OWNER COPY (INITIAL): PINK