IREDELL COUNTY HEALTH DEPARTMENT

STATESVILLE 704-878-5305 MOORESVILLE 704-664-5281

IMPROVEMENT PERMIT / AUTHORIZATION TO CONSTRUCT / OPERATION PERMIT / EXISTING SYSTEM INSPECTION

PERMIT# 104744 / 20785 PIN# 4762-31-2254 DATE March 18, 02

OWNER OR CONTRACTOR Bethesda Road LLC PHONE: Business _____ Home _____

ADDRESS P.O. Box 1732 Lincolnton N.C. 28092

LOCATION To East TR Bethesda TR Robins Hill Lane on Right

SUBDIVISION Fairwinds BLOCK / SECTION 2 LOT 23 LOT AREA .63Ac SITE CLASS. PS DESIGN FLOW 360gpd L.T.A.R. .25-.3

Septic Tank: 1000 Gallons; STB 1012 Date 12-23-03

Pump Tank: _____ Gallons; PT _____ Date _____

Pump Make: _____ Model _____ Serial No. _____

Nitrification Field: No Fields 1 Square Feet 410 Linear Feet 470

No Lines 6 Trench Width 36" Max Trench Bottom Depth 36" Gravel Depth 12"

☑ New System ☐ Repair System Type: I, II, III, IV, V, VI

System Description: Gravity conventional

Repair System Description: Gravity Innovative-25% Red

Maintenance Agreement Required: ☐ Yes ☑ No

☑ House/Mod. Home No. Bedrooms 3

☐ Mobile Home No. Bathrooms 2

☐ Business No. Employees ____

☐ Other _____

☐ Slab ☑ Crawl Space ☐ Basement w/plumbing ☐ Basement wo/plumbing


Water Supply: ☑ Individual ☐ Public ☐ Community

Comments:/Conditions:

Comments:/Conditions: SEPTIC TANK WITH MARKER INSTALLED USING "TUFTITE" FILTER

1"=50'

INITIAL SITE SKETCH

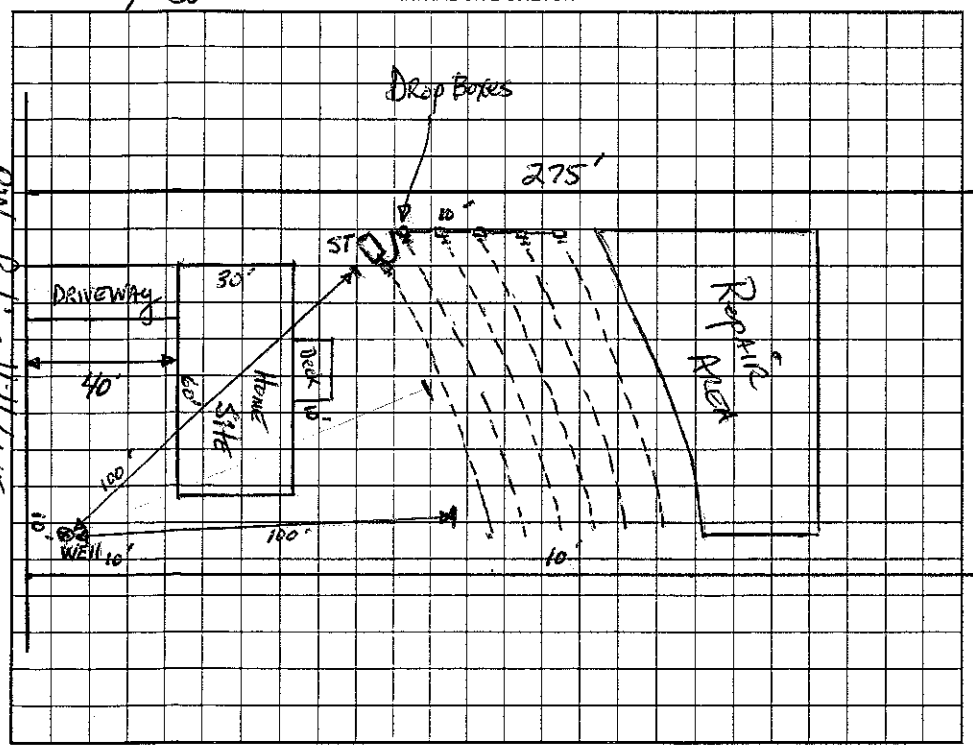

AS BUILT SKETCH

SYSTEM INSTALLED ACCORDING TO INITAL SITE SKETCH

100'

Permit can be suspended or revoked if any false information is supplied toward securing the permit/any unauthorized changes are made to the site/any unauthorized changes are made in the installation of the system. Improvement Permit with plat valid without expiration. Improvement Permit with site plan valid for sixty months. Authorization to Construct is valid for a period equal to that of Improvement Permit – not to exceed sixty months.

Signed: _____ date 3-25-02 Installed by: CRAIG THOMPSON

Improvement Permit by: _____ date 3-18-02 Operation Permit by: STEVE HEDRICK date 5-26-04

Authorization to Construct by: STEVE HEDRICK date 4-22-04 Existing System Inspection by: _____ date _____

HEALTH DEPT. COPY: WHITE OWNER COPY (FINAL): YELLOW OWNER COPY (INITIAL): PINK