# IREDELL COUNTY HEALTH DEPARTMENT

STATESVILLE 704-878-5305 MOORESVILLE 704-664-5281

## IMPROVEMENT PERMIT / AUTHORIZATION TO CONSTRUCT / OPERATION PERMIT / EXISTING SYSTEM INSPECTION

PERMIT# 109230 PIN# 4762-31-3978

OWNER OR CONTRACTOR BETHESDA ROAD LLC DATE 11/05/02

ADDRESS P.O. BOX 1732 LINCOLNTON, NC 28092 PHONE Business 704-736-4331 ~~704-791-5179~~

LOCATION HWY 70 EAST, (R) BETHESDA, (R) FAIRWINDS LANE, LOT ON RIGHT ~0.1 MILE,

SUBDIVISION FAIRWINDS BLOCK / SECTION LOT 40 LOT AREA 1.321 ACRES SITE CLASS PS DESIGN FLOW 480 GPD LTAR 0.30 GPD/FT²

Septic Tank: 1,000 Gallons. STB 1012 Date 11/14/02
Pump Tank: Gallons. PT Date
Pump Make. Model Serial No
Nitrification Field: No Fields 1 Square Feet EQ to 1,600 Linear Feet 400
No Lines 4@100' Trench Width 36" Max Trench Bottom Depth 36"

X New System Repair System Type I II III IV V VI
System Description 25% REDUCTION, GRAVITY
Repair System Description SAME
Maintenance Agreement Required Yes X No
Gravel Depth N/A Slab X Crawl Space Basement w/plumbing Basement wo/plumbing


House/Mod Home No Bedrooms 4
X Mobile Home No Bathrooms 2
Business No Employees
Other

Water Supply
X Individual
☐ Public
☐ Community
WELL


Comments/Conditions ① KEEP WELL AS FAR AS POSSIBLE (50' PLUS) ② INSTALL LINES ON CONTOUR ③ MAINTAIN ALL SETBACKS,

Comments Conditions SEPTIC TANK INSTALLED USING TUFF TIGHT OUTLET + SEPTIC MARKER

INITIAL SITE SKETCH

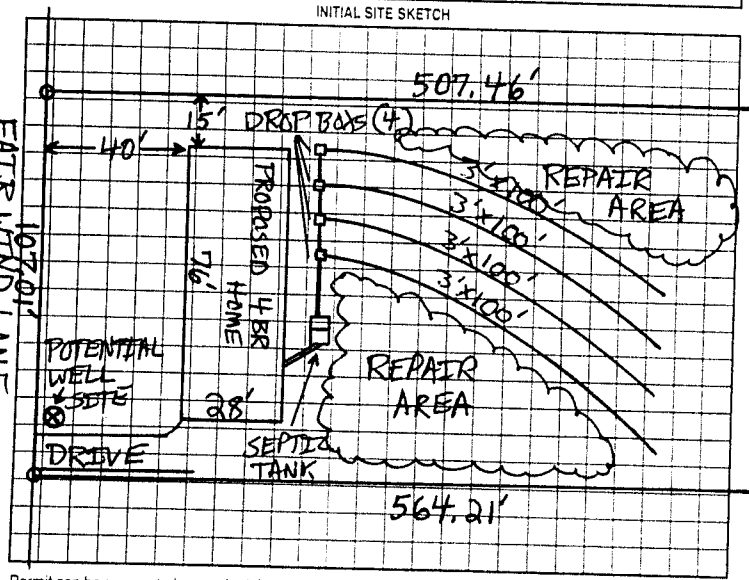


AS BUILT SKETCH

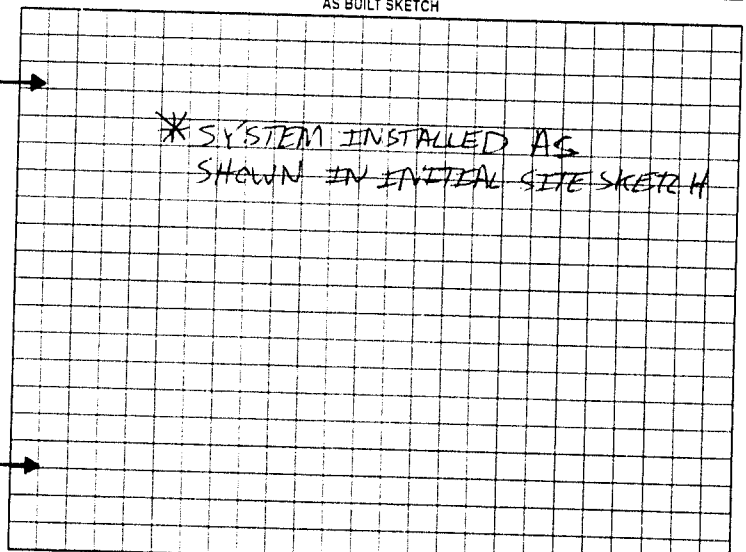


Permit can be suspended or revoked if any false information is supplied toward securing the permit any unauthorized changes are made to the site any unauthorized changes are made in the installation of the system. Improvement Permit with plat valid without expiration. Improvement Permit with site plan valid for sixty months. Authorization to Construct is valid for a period equal to that of Improvement Permit - not to exceed sixty months

Signed: [signature] date 11-6-02 Installed by A-1 BACKHOE

Improvement Permit by: Patrick Mitchell date 11/05/02 Operation Permit by Patrick Mitchell date 11/07/02

Authorization to Construct by: Patrick Mitchell date 11/05/02 Existing System Inspection by date

HEALTH DEPT COPY WHITE OWNER COPY (FINAL) YELLOW OWNER COPY (INITIAL) PINK