# IREDELL COUNTY HEALTH DEPARTMENT

STATESVILLE 704-878-5305 MOORESVILLE 704-664-5281

## IMPROVEMENT PERMIT / AUTHORIZATION TO CONSTRUCT / OPERATION PERMIT / EXISTING SYSTEM INSPECTION

PERMIT# 8400 1 PIN# 4762-21-7515 DATE 11-15-99

OWNER OR CONTRACTOR Piedmont Housing & Troutman, N.C. PHONE: Business 528 7120 Home

ADDRESS 1040 Charlotte Hwy

LOCATION 70 E TR Bethesda 2nd lot Past Fairwint

SUBDIVISION Fairwinds BLOCK / SECTION 1 LOT 8 LOT AREA .45 acres SITE CLASS PS DESIGN FLOW 360 L.T.A.R. 1.3

Septic Tank: 1000 Gallons; STB Date

Pump Tank: Gallons; PT Date

Pump Make: Model Serial No

Nitrification Field: No Fields 1 Square Feet 1200 Linear Feet 400

No Lines 5 Trench Width 36" Max Trench Bottom Depth 36" Gravel Depth 12"

☐ New System ☐ Repair System Type: I, II, III, IV, V, VI

System Description: Conv. Gravity

Repair System Description: Gravity 25% Reduct.

Maintenance Agreement Required: ☐ Yes ☐ No

☐ House/Mod. Home ☐ Mobile Home ☐ Business ☐ Other

No. Bedrooms 3 No. Bathrooms 2 No. Employees


☐ Slab ☐ Crawl Space ☐ Basement w/plumbing ☐ Basement wo/plumbing

Water Supply: ☐ Individual ☐ Public ☐ Community


Comments:/Conditions:

Comments:/Conditions:

INITIAL SITE SKETCH

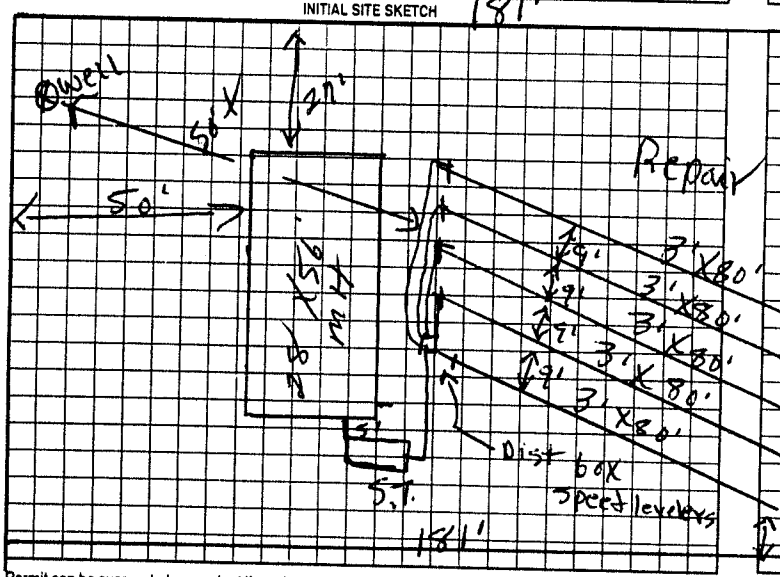


AS BUILT SKETCH

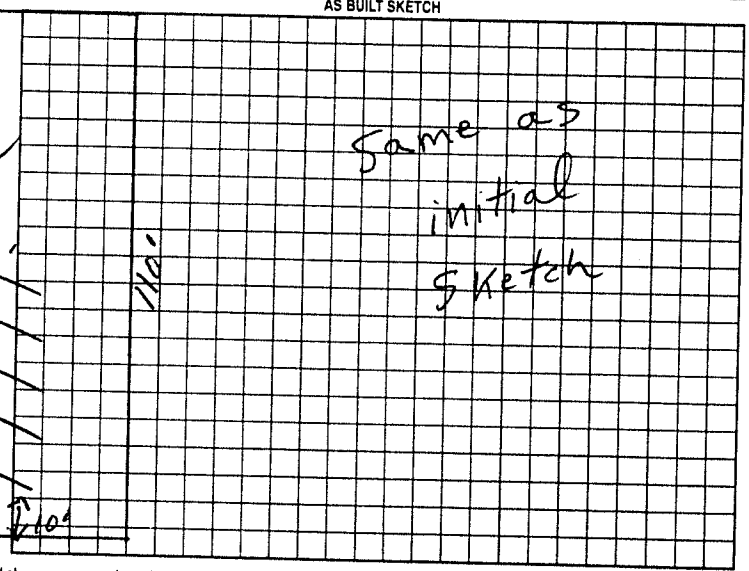


Permit can be suspended or revoked if any false information is supplied toward securing the permit/any unauthorized changes are made to the site/any unauthorized changes are made in the installation of the system. Improvement Permit with plat valid without expiration. Improvement Permit with site plan valid for sixty months. Authorization to Construct is valid for a period equal to that of Improvement Permit – not to exceed sixty months.

Signed: date 11-17-99 / Installed by: A-1 Backhoe

Improvement Permit by: P. C. Moore date 11-15-99 Operation Permit by: P. C. Moore date 2-08-00

Authorization to Construct by: P. C. Moore date 11-15-99 Existing System Inspection by: date

HEALTH DEPT. COPY: WHITE OWNER COPY (FINAL): YELLOW OWNER COPY (INITIAL): PINK