IREDELL COUNTY HEALTH DEPARTMENT

STATESVILLE 704-878-5305 MOORESVILLE 704-664-5281

IMPROVEMENT PERMIT / AUTHORIZATION TO CONSTRUCT / OPERATION PERMIT / EXISTING SYSTEM INSPECTION

PERMIT# 84008 PIN# 4762217515 DATE 11-15-99

OWNER OR CONTRACTOR Piedmont Housing PHONE: Business 528 7120 Home

ADDRESS 1040 Charlotte Hwy

LOCATION 70 E TR Bethesda at corner of Fairwinds

SUBDIVISION Fairwinds BLOCK / SECTION 1 LOT 7 LOT AREA 1.45 Acre SITE CLASS PS DESIGN FLOW 360 L.T.A.R. 1.3

Septic Tank: 1000 Gallons; STB 1012 Date 10-5-99
Pump Tank: Gallons; PT Date
Pump Make: Model Serial No.
Nitrification Field: No Fields 1 Square Feet 1200 Linear Feet 400
No Lines 5 Trench Width 36" Max Trench Bottom Depth 36" Gravel Depth 12"

☑ New System ☐ Repair System Type: I (II) III. IV. V. VI
System Description: Conv Gravity
Repair System Description: Gravity 25% reduction
Maintenance Agreement Required: ☐ Yes ☑ No


☐ House/Mod. Home No. Bedrooms 3
☑ Mobile Home No. Bathrooms 2
☐ Business No. Employees
☐ Other
☐ Slab ☐ Crawl Space ☐ Basement w/plumbing ☐ Basement wo/plumbing

Water Supply: ☑ Individual ☐ Public ☐ Community


Comments:/Conditions:

Comments:/Conditions:
Well Not on site at Time of This inspection

INITIAL SITE SKETCH

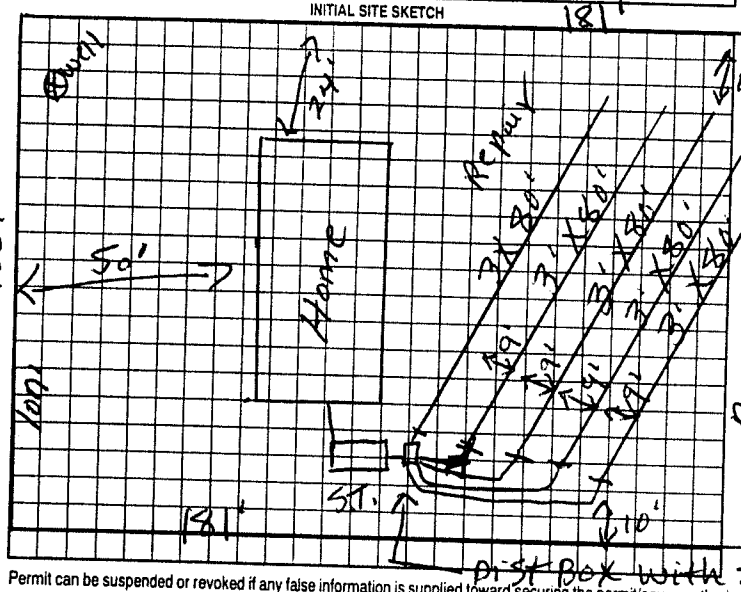

AS BUILT SKETCH

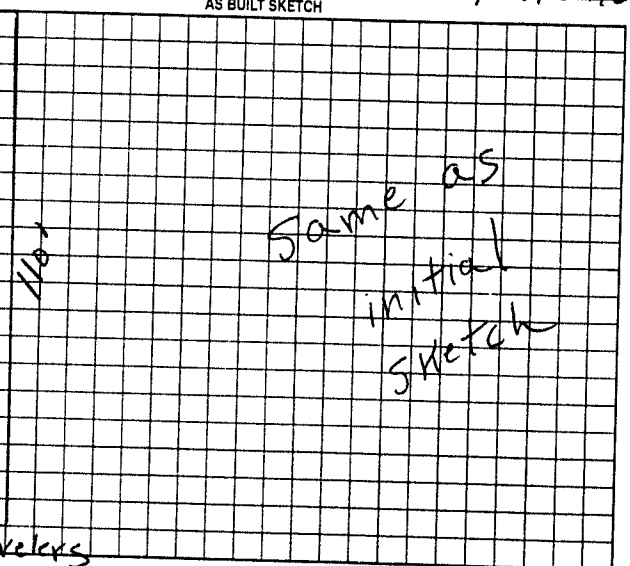

Pi-St Box with speed levelers

Permit can be suspended or revoked if any false information is supplied toward securing the permit/any unauthorized changes are made to the site/any unauthorized changes are made in the installation of the system. Improvement Permit with plat valid without expiration. Improvement Permit with site plan valid for sixty months. Authorization to Construct is valid for a period equal to that of Improvement Permit – not to exceed sixty months.

Signed: KM/MC date 11-17-99 Installed by: A-1 Backhoe

Improvement Permit by: P. C. Moore date 11-15-99 Operation Permit by: P. C. Moore date 2-2-00

Authorization to Construct by: P. C. Moore date 11-15-99 Existing System Inspection by: date

HEALTH DEPT. COPY: WHITE OWNER COPY (FINAL): YELLOW OWNER COPY (INITIAL): PINK