IREDELL COUNTY HEALTH DEPARTMENT

STATESVILLE 704-878-5305 MOORESVILLE 704-664-5281

IMPROVEMENT PERMIT / AUTHORIZATION TO CONSTRUCT / OPERATION PERMIT / EXISTING SYSTEM INSPECTION

PERMIT# 93998 PIN# 4762217515 DATE 10-14-99

OWNER OR CONTRACTOR Piedmont Housing PHONE: Business 528-7120 Home

ADDRESS 1040 Charlotte Hwy

LOCATION 70 E TR Bethesda Rd across from Bethesda Ch. Troutman N.C.

SUBDIVISION Fairwinds BLOCK / SECTION 1 LOT 5 LOT AREA .45 acre SITE CLASS. PS DESIGN FLOW 360 L.T.A.R. .3

Septic Tank: 1000 Gallons; STB 1012 Date 7-31-99

Pump Tank: Gallons; PT Date

Pump Make: Model Serial No.

Nitrification Field: No Fields 1 Square Feet 900 Linear Feet 300

No Lines 4 Trench Width 36" Max Trench Bottom Depth 36" Gravel Depth N/A

☑ New System ☐ Repair System Type: I. II. III. IV. V. VI

System Description: Gravity 25% Reductions

Repair System Description:

Maintenance Agreement Required: ☐ Yes ☑ No

☐ House/Mod. Home ☐ Mobile Home ☐ Business ☐ Other

No. Bedrooms 3 No. Bathrooms 2 No. Employees


Water Supply: ☐ Individual ☐ Public ☐ Community

☐ Slab ☐ Crawl Space ☐ Basement w/plumbing ☐ Basement wo/plumbing

Comments:/Conditions: Improve landscape + Drainage at edge of old Farm field where water will not stand over Drain-lines

Comments:/Conditions:

INITIAL SITE SKETCH

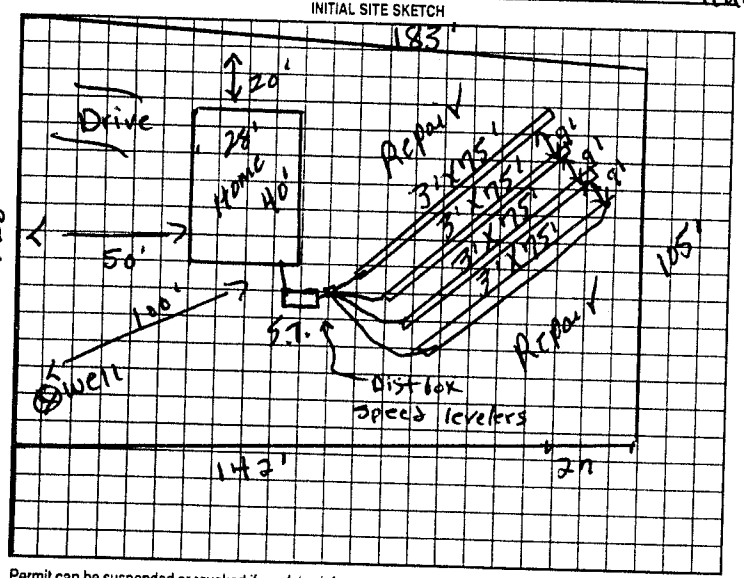

AS BUILT SKETCH

Same as initial sketch

Permit can be suspended or revoked if any false information is supplied toward securing the permit/any unauthorized changes are made to the site/any unauthorized changes are made in the installation of the system. Improvement Permit with plat valid without expiration. Improvement Permit with site plan valid for sixty months. Authorization to Construct is valid for a period equal to that of Improvement Permit – not to exceed sixty months.

Signed: Dennis Gallihar date 10-14-99 Installed by: A-1 Backhoe

Improvement Permit by: J.C. Moore date 10-14-99 Operation Permit by: J.C. Moore date 10-15-99

Authorization to Construct by: J.C. Moore date 10-14-99 Existing System Inspection by: date

HEALTH DEPT. COPY: WHITE OWNER COPY (FINAL): YELLOW OWNER COPY (INITIAL): PINK