IREDELL COUNTY HEALTH DEPARTMENT

STATESVILLE 704-878-5305 CI MOORESVILLE 704-664-5281

IMPROVEMENT PERMIT / AUTHORIZATION TO CONSTRUCT / OPERATION PERMIT / EXISTING SYSTEM INSPECTION

PERMIT# 83997 PIN# 4762217515 4762-32-3340 DATE 10-14-99

OWNER OR CONTRACTOR Piedmont Housing PHONE: Business 528 7120 Home

ADDRESS 1040 Charlotte Hwy Troutman N.C.

LOCATION US 70 E TR Bethesda Rd across from Bethesda ch.

SUBDIVISION Fairwinds BLOCK / SECTION 1 LOT 4 LOT AREA 3.35 acres SITE CLASS. PS DESIGN FLOW 360 L.T.A.R. .3

Septic Tank: 1000 Gallons; STB 1012 Date 10-20-02

Pump Tank: Gallons; PT Date

Pump Make: Model Serial No.

Nitrification Field: No Fields 1 Square Feet 1200 Linear Feet 400

No Lines 3 Trench Width 36" Max Trench Bottom Depth 36" Gravel Depth 12"

☒ New System ☐ Repair System Type: I, II, III, IV, V, VI

System Description: Conv. Gravity

Repair System Description:

Maintenance Agreement Required: ☐ Yes ☒ No

☐ House/Mod. Home No. Bedrooms 3

☒ Mobile Home No. Bathrooms 2

☐ Business No. Employees

☐ Other

☐ Slab ☒ Crawl Space ☐ Basement w/plumbing ☐ Basement wo/plumbing


Water Supply: ☒ Individual ☐ Public ☒ Community

Comments:/Conditions:


Comments:/Conditions:

Standard Trench - Site Filter Installed
- red/yellow soil mottling & chroma 2 observed in Nitrification line areas dug.

INITIAL SITE SKETCH

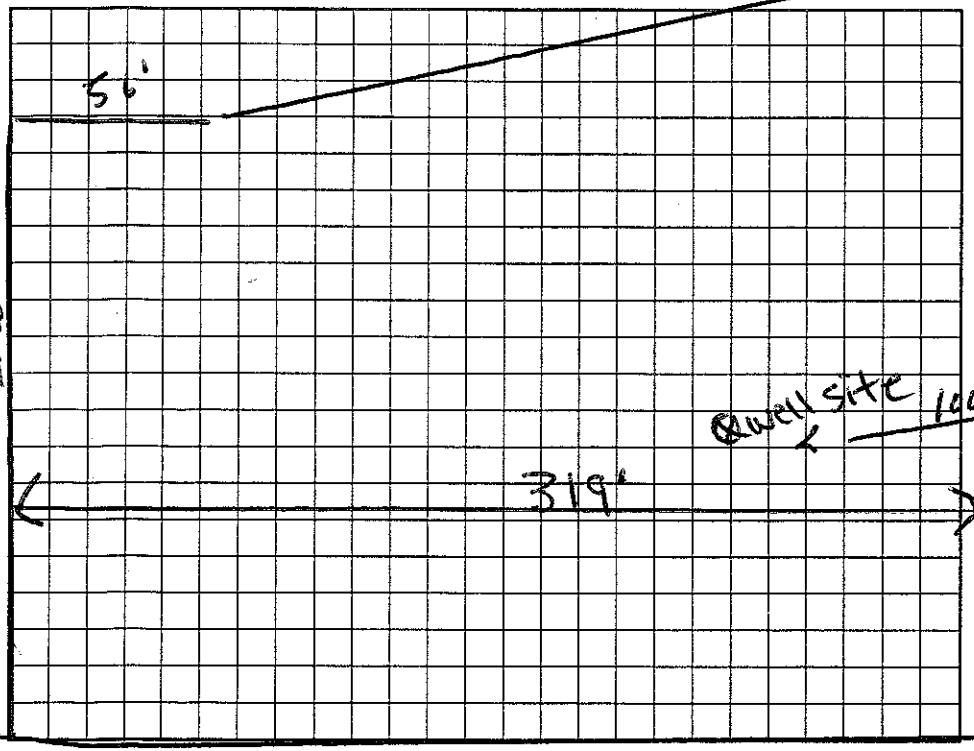

AS BUILT SKETCH

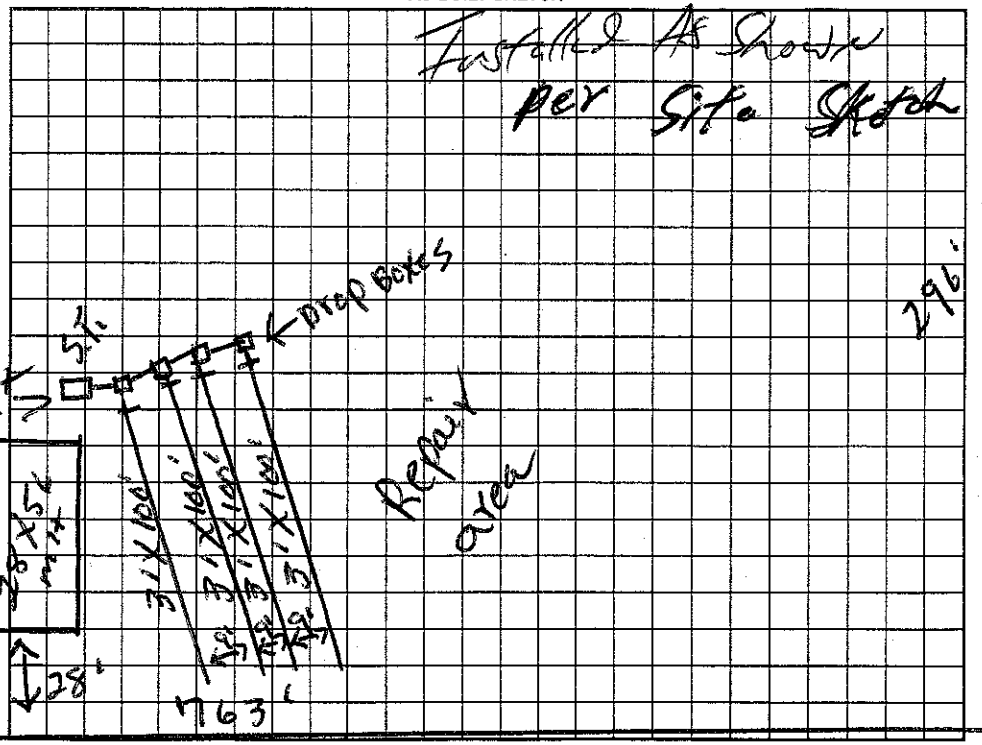

Permit can be suspended or revoked if any false information is supplied toward securing the permit/any unauthorized changes are made to the site/any unauthorized changes are made in the installation of the system. Improvement Permit with plat valid without expiration. Improvement Permit with site plan valid for sixty months. Authorization to Construct is valid for a period equal to that of Improvement Permit – not to exceed sixty months.

Signed: RM Hall date 10-15-99 Installed by: C. Thompson

Improvement Permit by: L.C. Moore date 10-14-99 Operation Permit by: William O. Johnson date 5/16/03

Authorization to Construct by: L.C. Moore date 10-14-99 Existing System Inspection by: date

HEALTH DEPT. COPY: WHITE OWNER COPY (FINAL): YELLOW OWNER COPY (INITIAL): PINK