IREDELL COUNTY HEALTH DEPARTMENT

STATESVILLE 704-878-5305 MOORESVILLE 704-664-5281

IMPROVEMENT PERMIT / AUTHORIZATION TO CONSTRUCT / OPERATION PERMIT / EXISTING SYSTEM INSPECTION

PERMIT# 144632 PIN# 4762349556

OWNER OR APPLICANT Betty C Yates

ADDRESS 105 Derby Dr Statesville NC 28677 PHONE: Business _____ Home 704-873-1094 DATE 9-27-07

LOCATION 70E (TL) Bethesda RD (TR) Derby

SUBDIVISION _____ BLOCK / SECTION _____ LOT _____ LOT AREA 1.93 SITE CLASS P5 DESIGN FLOW 240 L.T.A.R. _____

Septic Tank: 1000 Gallons; STB _____ Date _____

Pump Tank: _____ Gallons; PT _____ Date _____

Pump Make: _____ Model _____ Serial No. _____

Nitrification Field: No. Fields ___ Square Feet _____ Linear Feet 150+

No. Lines 2 Trench Width _____ Max Trench Bottom Depth 60" Gravel Depth _____

☑ New System ☐ Repair ☐ Expansion System Type: I (II) III IV V VI

System Description: Gravel Drain

Repair System Description: Pump 25%

Maintenance Agreement Required: ☐ Yes ☐ No

☐ House/Mod. Home ☑ Mobile Home ☐ Business ☐ Other

No. Bedrooms 2 No. Persons ___ No. Employees ___

Water Supply: ☐ Individual ☑ Public ☐ Community

☑ Gravity ☐ Pressure ☐ Slab ☑ Crawl Space ☐ Basement w/plumbing ☐ Basement wo/plumbing


Comments:/Conditions:

System Previously Repaired
Approved for 2 Bedroom

Comments:/Conditions:

INITIAL SITE SKETCH

AS BUILT SKETCH

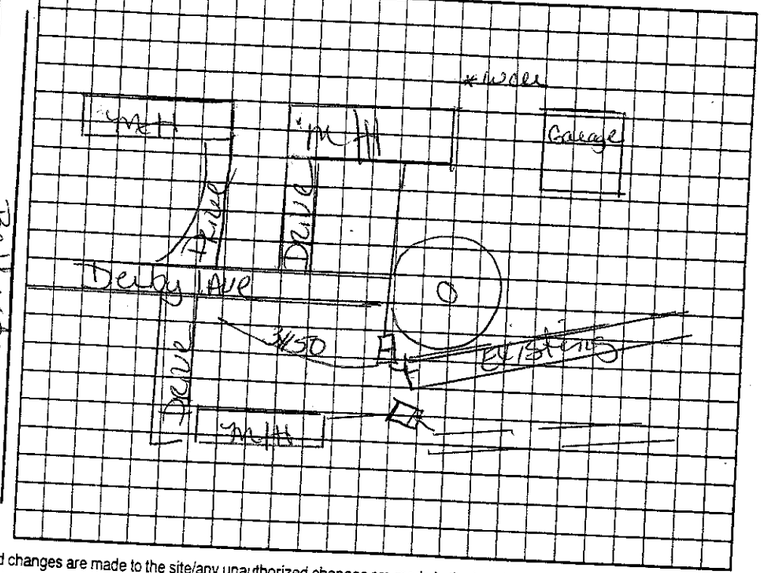

Permit can be suspended or revoked if any false information is supplied toward securing the permit/any unauthorized changes are made to the site/any unauthorized changes are made in the installation of the system. Improvement Permit with plat valid without expiration ☐ Improvement Permit with site plan valid for sixty months ☐ Authorization to Construct is valid for a period equal to that of Improvement Permit – not to exceed sixty months.

Signed: _____ date _____

Improvement Permit by: _____ date _____

Authorization to Construct by: _____ date _____

Installed by: _____

Operation Permit by: _____ date _____

Existing System Inspection by: Kevin L Cook date 9-27-07

HEALTH DEPT. COPY: WHITE OWNER COPY (FINAL): YELLOW OWNER COPY (INITIAL): PINK