# IREDELL COUNTY HEALTH DEPARTMENT

STATESVILLE 704-878-5305 MOORESVILLE 704-664-5281

## IMPROVEMENT PERMIT / AUTHORIZATION TO CONSTRUCT / OPERATION PERMIT / EXISTING SYSTEM INSPECTION

PERMIT# 88382 PIN# 4761 42 4318 DATE 4-6-00

OWNER OR CONTRACTOR Piedmont Housing PHONE: Business 704 489 1113 Home

ADDRESS 4879 North Hwy 16 Denver, N.C.

LOCATION Moe to Bethesda Tb Hickory Nut 4th lot Rt.

SUBDIVISION Laurel Grove BLOCK / SECTION LOT 55 LOT AREA 1.82 acres SITE CLASS. PS DESIGN FLOW 480 L.T.A.R. .32

Septic Tank: 1000 Gallons: STB 821 Date 1-11-2000

Pump Tank: Gallons: PT Date

Pump Make: Model Serial No.

Nitrification Field: No Fields 1 Square Feet 1500 Linear Feet 500

No Lines 5 Trench Width 36" Max Trench Bottom Depth 36" Gravel Depth 12"

☑ New System ☐ Repair System Type: I, II, III, IV, V, VI

System Description: Conv. Gravity

Repair System Description: " "

Maintenance Agreement Required: ☐ Yes ☑ No

☐ Slab ☑ Crawl Space ☐ Basement w/plumbing ☐ Basement wo/plumbing

☐ House/Mod. Home No. Bedrooms 3

☑ Mobile Home No. Bathrooms 2

☐ Business No. Employees


☐ Other

Water Supply: ☑ Individual ☐ Public ☐ Community


Comments/Conditions:

Comments/Conditions:

INITIAL SITE SKETCH

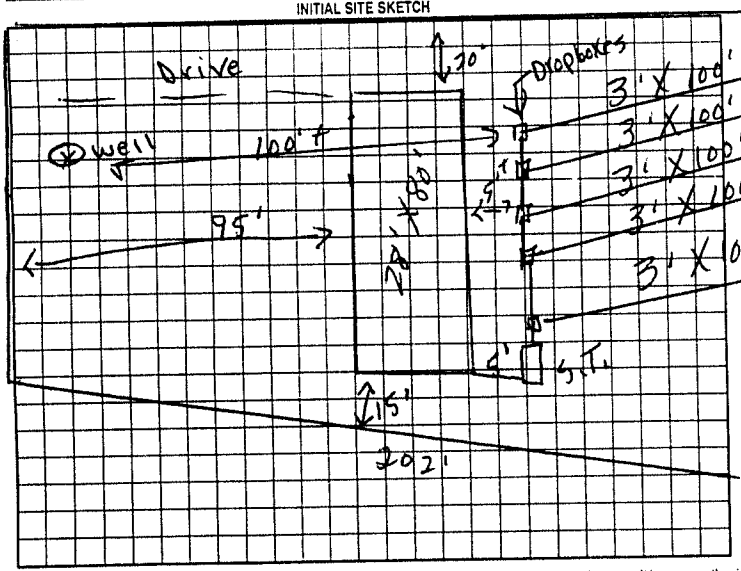


AS BUILT SKETCH

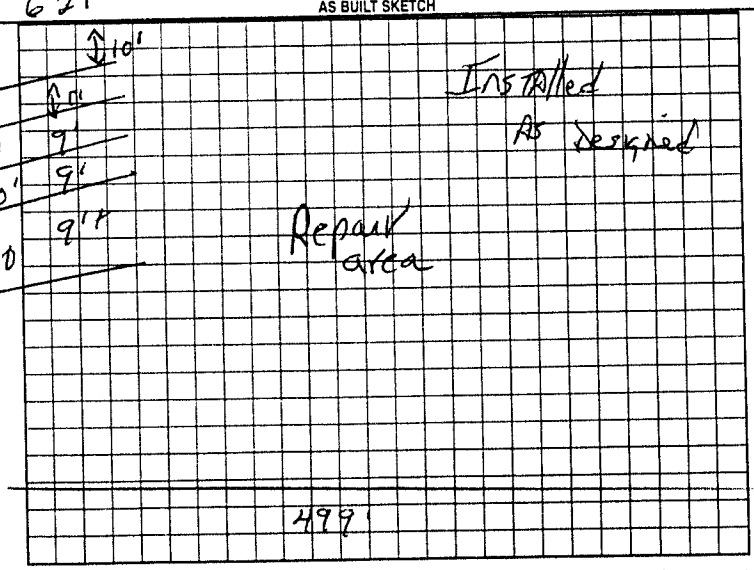


Permit can be suspended or revoked if any false information is supplied toward securing the permit/any unauthorized changes are made to the site/any unauthorized changes are made in the installation of the system. Improvement Permit with plat valid without expiration. Improvement Permit with site plan valid for sixty months. Authorization to Construct is valid for a period equal to that of Improvement Permit – not to exceed sixty months.

Signed: [signature] date 4/6/00 Installed by: Foothills Grading

Improvement Permit by: P. C. Moore date 4-6-00 Operation Permit by: date April 17 2000

Authorization to Construct by: P. C. Moore date 4-6-00 Existing System Inspection by: date

HEALTH DEPT. COPY: WHITE OWNER COPY (FINAL): YELLOW OWNER COPY (INITIAL): PINK