0003000

135 Hickory Nut Dr.

IREDELL COUNTY HEALTH DEPARTMENT

STATESVILLE 704-878-5305 MOORESVILLE 704-664-5281

IMPROVEMENT PERMIT / AUTHORIZATION TO CONSTRUCT / OPERATION PERMIT / EXISTING SYSTEM

PERMIT # 83-2890 PIN 4762 42 5072 16 DATE

OWNER OR CONTRACTOR American Land Group PHONE: Business 878 9595 Home

ADDRESS 1238 Garner Bagnal Blvd Statesville

LOCATION I-77 E TR Bethesda TL Hickory Nut Dr 1st Left

SUBDIVISION Laurel Grove BLOCK / SECTION LOT 5 LOT AREA 1 Acres SITE CLASS 105 DESIGN FLOW 360 GAL/DAY

Septic Tank: 1000 Gallons: STB: 012 Date: 7-27-99 ☐ New System ☐ Repair System (Type) ☐ Initial ☐ Repair ☐ Horse/Mod. Home ☐ Not Bedrooms

Pump Tank: Gallons: PT Date: System Description: Conv. ☑ Mobile Home ☐ Not Bathrooms


Pump Make: Model: Serial No: Repair System Description: ☐ Business ☐ Not Employees

Nitrification Field: No. Poles: 1 Square Feet: 1440 Linear Feet: 480 Maintenance Agreement Required: Yes / No ☐ Other


No. Lines: 4 Trench Width: 36" Max. Trench Bottom Depth: 36" Gravel Depth: 12" Slab / Crawl Space ☐ Basement w/plumbing ☐ Basement w/o plumbing

Comments / Conditions: Comments / Conditions: SEPTIC TANKS WITH RISERS, POLYLOK FILTER SYSTEM INSPECTED BY OWNER

INITIAL SITE SKETCH — 5.12 ac

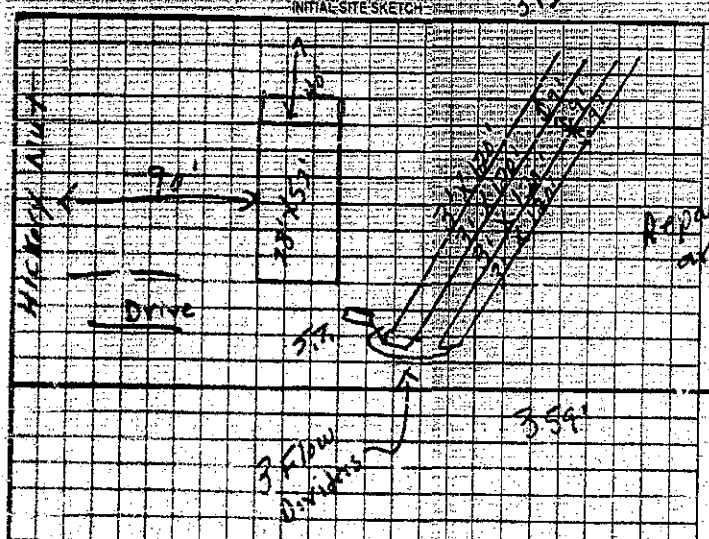

AS-BUILT SKETCH

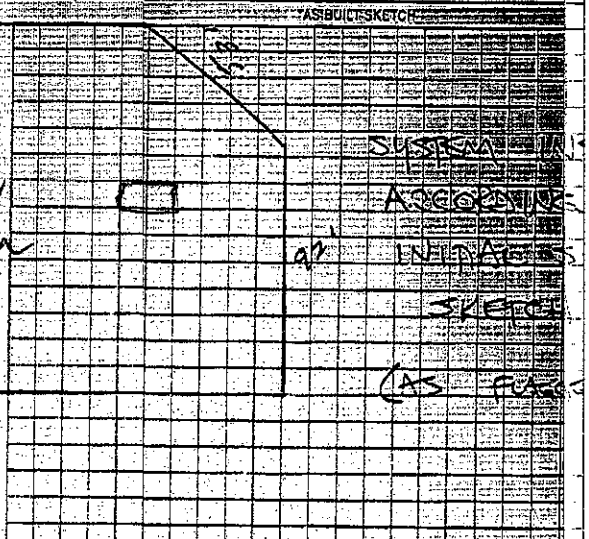

Permit can be suspended or revoked if any false information is supplied toward securing the permit, any unauthorized changes are made to the site, any unauthorized changes are made in the installation of the... Permit with plat valid without expiration. Improvement Permit with site plan valid for sixty months. Authorization to Construct is valid for a period equal to that of Improvement Permit – not to exceed sixty m...

Signed Owner or Agent date 8-19-97 Installed by: KENNY MADISON

Improvement Permit by: R.C. Moore date: 8-18-97 Operation Permit by: STEVE HENDRICK date

Authorization to Construct by: R.C. Moore date 8-18-97 Existing System Inspection by: date

HEALTH DEPT. COPY: WHITE OWNER COPY (FINAL): YELLOW OWNER COPY (INITIAL): PINK

The proposed 16'x26' Attached garage addition does not appear to impact the existing septic system. 20'x20' carport

**NOTE: Carport is drawn below repair area

R.S.

Date: 7-14-09

ICHD-Environmental Health Division

JAN. 23, 1989 8:01