# IREDELL COUNTY HEALTH DEPARTMENT

STATESVILLE 704-878-5305 MOORESVILLE 704-664-5281

## IMPROVEMENT PERMIT / AUTHORIZATION TO CONSTRUCT / OPERATION PERMIT / EXISTING SYSTEM INSPECTION

PERMIT# 77986 PIN# 4762516439 DATE 12-16-98

OWNER OR CONTRACTOR American Land PHONE: Business 8789595 Home

ADDRESS 1281 Garner Bagnal BLVD. Statesville

LOCATION 70 E TR Bethesda PL Hickory Nut 8th lot on Rt.

SUBDIVISION Laurel Grove BLOCK / SECTION LOT 51 LOT AREA 1.29acres SITE CLASS. PS DESIGN FLOW 360 L.T.A.R. .28

Septic Tank: 1000 Gallons; STB 1012 Date 9-21-99
Pump Tank: Gallons; PT Date
Pump Make: Model Serial No.
Nitrification Field: No Fields 1 Square Feet 1050 Linear Feet 350
No Lines 6 Trench Width 36" Max Trench Bottom Depth 36" Gravel Depth N/A

☒ New System ☐ Repair System Type: I, II, III, IV, V, VI
System Description: Gravity 25% Red
Repair System Description: " " "
Maintenance Agreement Required: ☐ Yes ☒ No

☒ House/Mod. Home ☐ Mobile Home ☐ Business ☐ Other
No. Bedrooms 3
No. Bathrooms 2
No. Employees


☐ Slab ☒ Crawl Space ☐ Basement w/plumbing ☐ Basement wo/plumbing

Water Supply: ☒ Individual ☐ Public ☐ Community


Comments:/Conditions:

Comments:/Conditions: ① SEPTIC TANK W/ RISERS INSTALLED USING "POLYLOK" FILTER ② EXTRA LINE INSTALLED TO ACCOMODATE # OF CHAMBERS

INITIAL SITE SKETCH

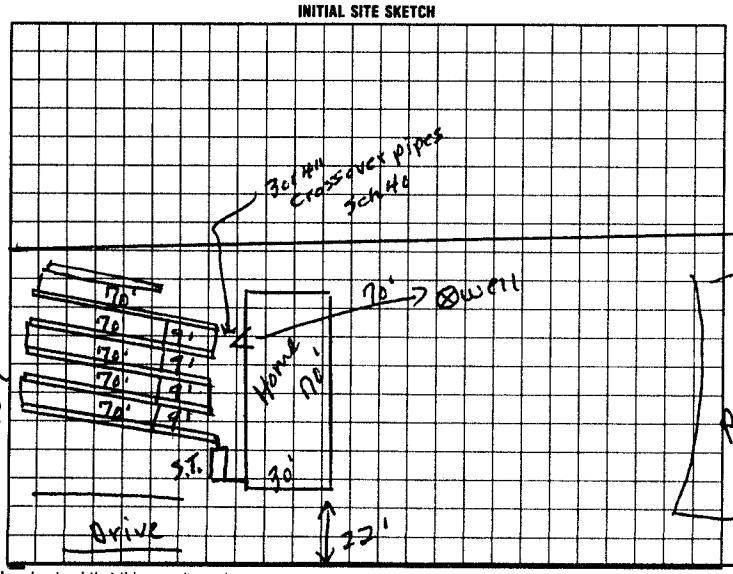


AS BUILT SKETCH

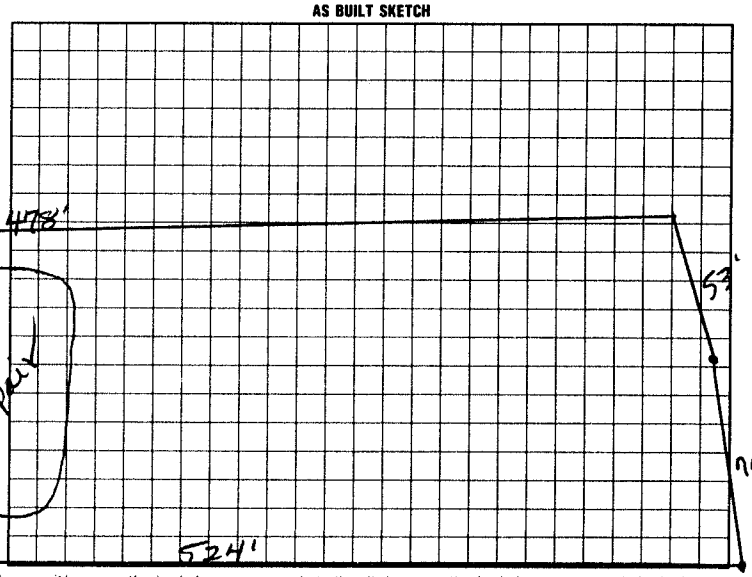


I understand that this permit can be suspended or revoked if any false information is supplied toward securing the permit/any unauthorized changes are made to the site/any unauthorized changes are made in the installation of the system. Improvement Permit with plat valid without expiration. Improvement Permit with site plan valid for sixty months. Authorization to Construct is valid for a period equal to that of Improvement Permit – not to exceed sixty months.

Signed: Claudette Ballard date 12-16-98 Installed by: CRAIG THOMPSON

Improvement Permit by: J.C. Moore date 12-16-98 Operation Permit by: STEVE HEDRICK date 3-3.00

Authorization to Construct by: J.C. Moore date 12-16-98 Existing System Inspection by: date

HEALTH DEPT. COPY: WHITE INSPECTION COPY (FINAL): GREEN OWNER COPY (FINAL) YELLOW INSPECTION COPY (INITIAL): PINK OWNER COPY (INITIAL): GOLD