IREDELL COUNTY HEALTH DEPARTMENT

STATESVILLE 704-878-5305 MOORESVILLE 704-664-5281

IMPROVEMENT PERMIT / AUTHORIZATION TO CONSTRUCT / OPERATION PERMIT / EXISTING SYSTEM INSPECTION

PERMIT# 19825 / 19974 PIN# 4762 51 6439 DATE 12-8-98

OWNER OR CONTRACTOR American Land PHONE: Business 878 9595 Home

ADDRESS 1281 Garner Bagnal Blvd Statesville

LOCATION TD @ E TR Bethesda Rd TL Hickory Nut 7th on left

SUBDIVISION Laurel Grove BLOCK / SECTION LOT 7 LOT AREA 1.2 acres SITE CLASS PS DESIGN FLOW 360 L.T.A.R. .33

Septic Tank: 1000 Gallons; STB 1012 Date 11 3 98

Pump Tank: Gallons; PT Date

Pump Make: Model Serial No.

Nitrification Field: No Fields 1 Square Feet 1080 Linear Feet 360

No Lines 3 Trench Width 36" Max Trench Bottom Depth 36" Gravel Depth 12"

☒ New System ☐ Repair System Type: I (II) III, IV, V, VI

System Description: Conv. Gravity

Repair System Description: " "

Maintenance Agreement Required: ☐ Yes ☒ No

☐ House/Mod. Home ☐ Mobile Home ☐ Business ☐ Other

No. Bedrooms 3 No. Bathrooms 2 No. Employees

☐ Slab ☒ Crawl Space ☐ Basement w/plumbing ☐ Basement wo/plumbing


Water Supply: ☒ Individual ☐ Public ☐ Community

Comments:/Conditions:


Comments:/Conditions:

well is not on site at time of inspection located as shown

INITIAL SITE SKETCH

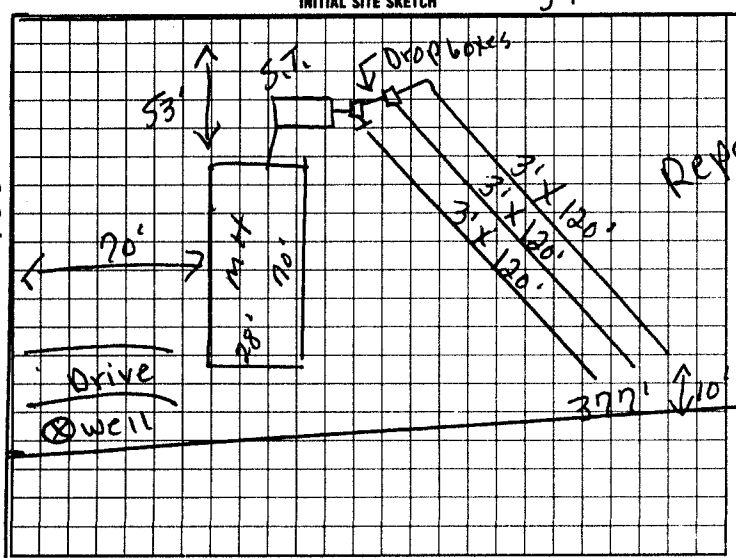

AS BUILT SKETCH

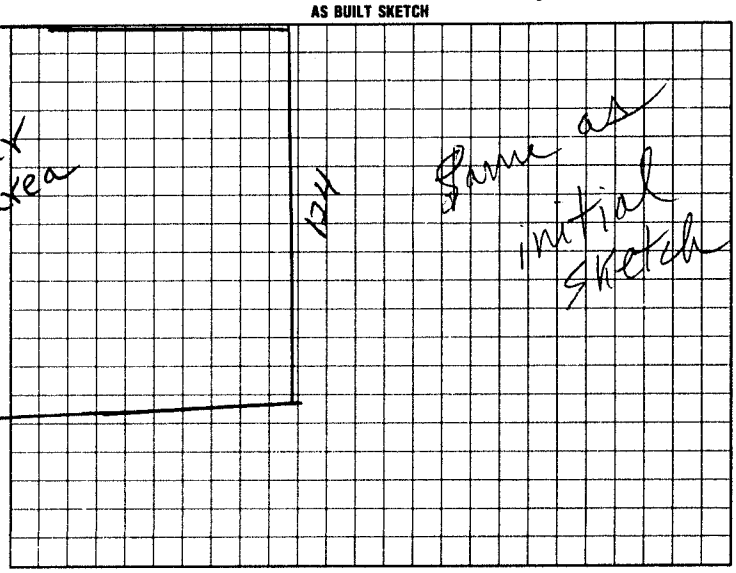

I understand that this permit can be suspended or revoked if any false information is supplied toward securing the permit/any unauthorized changes are made to the site/any unauthorized changes are made in the installation of the system. Improvement Permit with plat valid without expiration. Improvement Permit with site plan valid for sixty months. Authorization to Construct is valid for a period equal to that of Improvement Permit – not to exceed sixty months.

Signed: Claudette Bullard date 12-10-98 Installed by: A-1 Backhoe

Improvement Permit by: P.C. Moore date 12-8-98 Operation Permit by: P.C. Moore date 2-5-99

Authorization to Construct by: P.C. Moore date 12-8-98 Existing System Inspection by: — date

HEALTH DEPT. COPY: WHITE INSPECTION COPY (FINAL): GREEN OWNER COPY (FINAL): YELLOW INSPECTION COPY (INITIAL): PINK OWNER COPY (INITIAL): GOLD