IREDELL COUNTY HEALTH DEPARTMENT

STATESVILLE 704-878-5305 MOORESVILLE 704-664-5281

IMPROVEMENT PERMIT / AUTHORIZATION TO CONSTRUCT / OPERATION PERMIT / EXISTING SYSTEM INSPECTION

PERMIT# 17985 PIN# 4762516439 DATE 12-16-98

OWNER OR CONTRACTOR American Land PHONE: Business 8789595 Home

ADDRESS 1258 Garner Bagnal BLVD

LOCATION 70E TR Bethesta Tb Hickory Nut Rd 9th lot Rt.

SUBDIVISION Laurel Grove BLOCK / SECTION LOT 50 LOT AREA 1.3 acres SITE CLASS PS DESIGN FLOW 360 L.T.A.R. .28

Septic Tank: 1000 Gallons; STB 660 Date 10-12
Pump Tank: Gallons; PT Date
Pump Make: Model Serial No.
Nitrification Field: No Fields 1 Square Feet 1050 Linear Feet 350
No Lines 6 Trench Width 36" Max Trench Bottom Depth 36" Gravel Depth N/A

☑ New System ☐ Repair System Type: I. II (III) IV. V. VI
System Description: Gravity 25% Red.
Repair System Description: Shallow Placed 25% Red.
Maintenance Agreement Required: ☐ Yes ☑ No

☐ House/Mod. Home ☑ Mobile Home ☐ Business ☐ Other
No. Bedrooms 3 No. Bathrooms 2 No. Employees


☑ Slab ☐ Crawl Space ☐ Basement w/plumbing ☐ Basement wo/plumbing

Water Supply: ☑ Individual ☐ Public ☐ Community


Comments:/Conditions:

Comments:/Conditions:

INITIAL SITE SKETCH

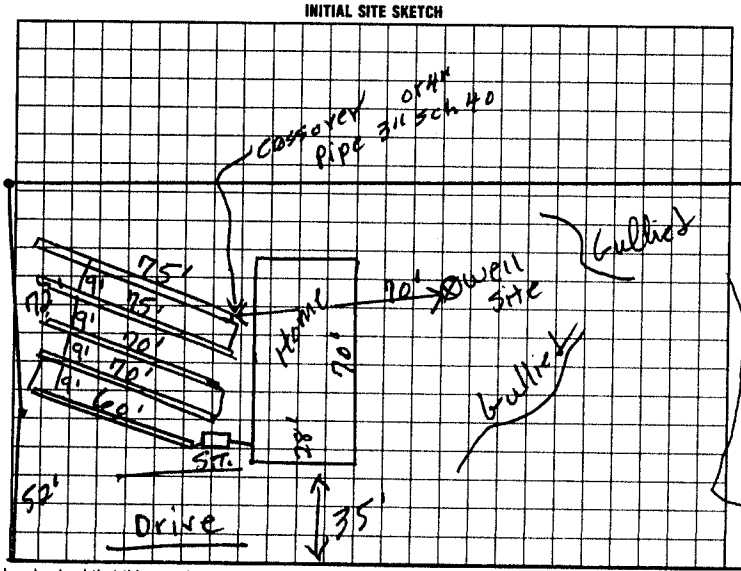

AS BUILT SKETCH

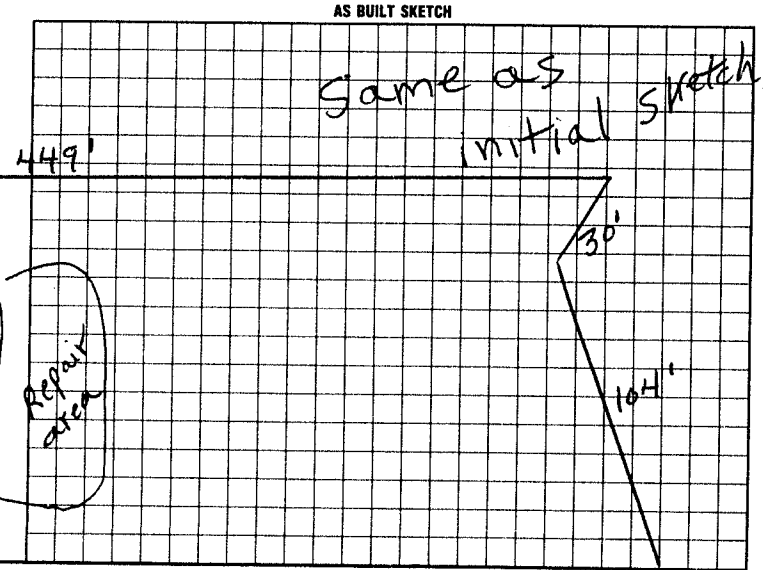

I understand that this permit can be suspended or revoked if any false information is supplied toward securing the permit/any unauthorized changes are made to the site/any unauthorized changes are made in the installation of the system. Improvement Permit with plat valid without expiration. Improvement Permit with site plan valid for sixty months. Authorization to Construct is valid for a period equal to that of Improvement Permit – not to exceed sixty months.

Signed: Claude H. Bullard date 12-16-98 Installed by: Harvey Leatherman S.T. Co.

Improvement Permit by: R.C. Moore date 12-16-98 Operation Permit by: R.C. Moore date 11-15-99

Authorization to Construct by: R.C. Moore date 12-16-98 Existing System Inspection by: date

HEALTH DEPT. COPY. WHITE INSPECTION COPY (FINAL) GREEN OWNER COPY (FINAL) YELLOW INSPECTION COPY (INITIAL). PINK OWNER COPY (INITIAL). GOLD