IREDELL COUNTY HEALTH DEPARTMENT

STATESVILLE 704-878-5305 MOORESVILLE 704-664-5281

50145

IMPROVEMENT PERMIT / CERTIFICATE OF COMPLETION / OPERATION PERMIT / EXISTING SYSTEM INSPECTION

PROPERTY DESCRIPTION NO. 17747 DATE 1-28-94 TAX MAP NO. 5E-A-82 Watershed: ☐ Yes ☒ No

OWNER OR CONTRACTOR Charles W. Williams PHONE: Business Home 873-6259

ADDRESS 105 Artist Lane

LOCATION 70E TR Bethesda Rd Past Bridge on R at Artist Lane

SUBDIVISION BLOCK / SECTION LOT LOT AREA 1.22 acres SITE CLASS. PS DESIGN FLOW 360 L.T.A.R. .4

Septic Tank: EX. Gallons; STB Date

Pump Tank: Gallons; PT Date

Pump Make: Model Serial No.

Nitrification Field: No Fields Square Feet 300 Linear Feet 100

No Lines 2 Trench Width 36 Max Trench Bottom Depth 36 Gravel Depth

☐ New System ☐ Repair System Type: I, II, III, IV, V, VI

System Description:

Repair System Description:

Maintenance Agreement Required: ☐ Yes ☐ No

☐ House/Mod. Home ☒ Mobile Home ☐ Business ☐ Other

No. Bedrooms 3 No. Bathrooms 2 No. Employees

☐ Slab ☐ Crawl Space ☐ Basement w/plumbing ☐ Basement wo/plumbing


Water Supply: ☒ Individual ☐ Community ☐ Public well next door

Comments:


System installed 4-21-88
1000 gal ST. 200'
Adding 100' line for 3 bedroom Home

Comments:

INITIAL SITE SKETCH

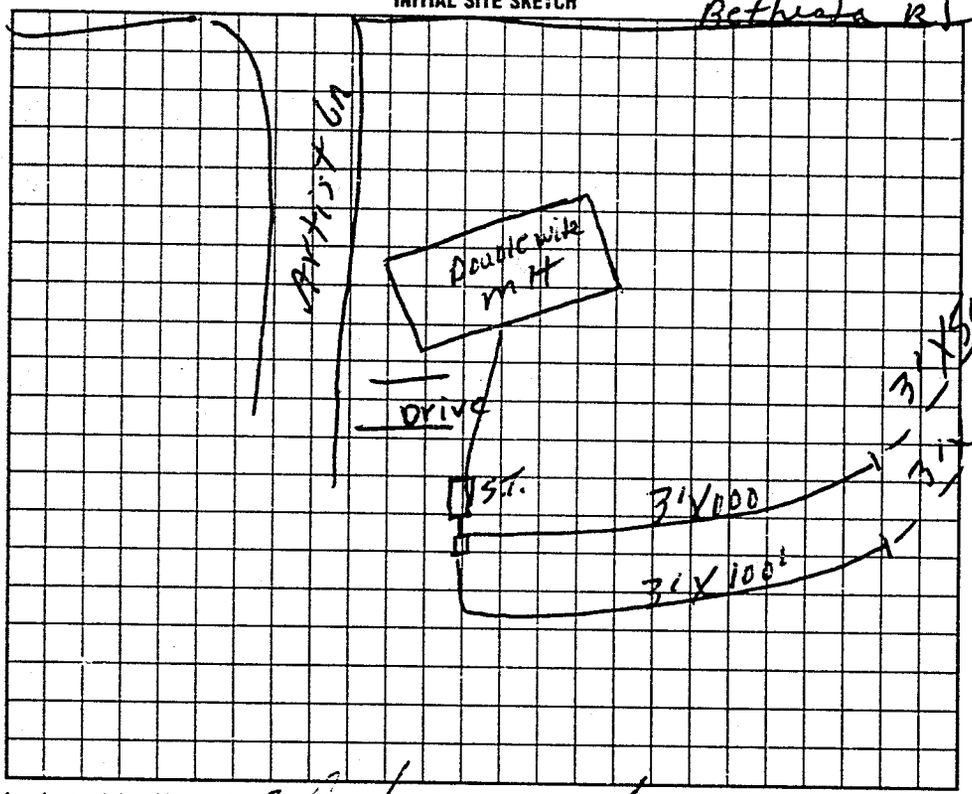

AS BUILT SKETCH

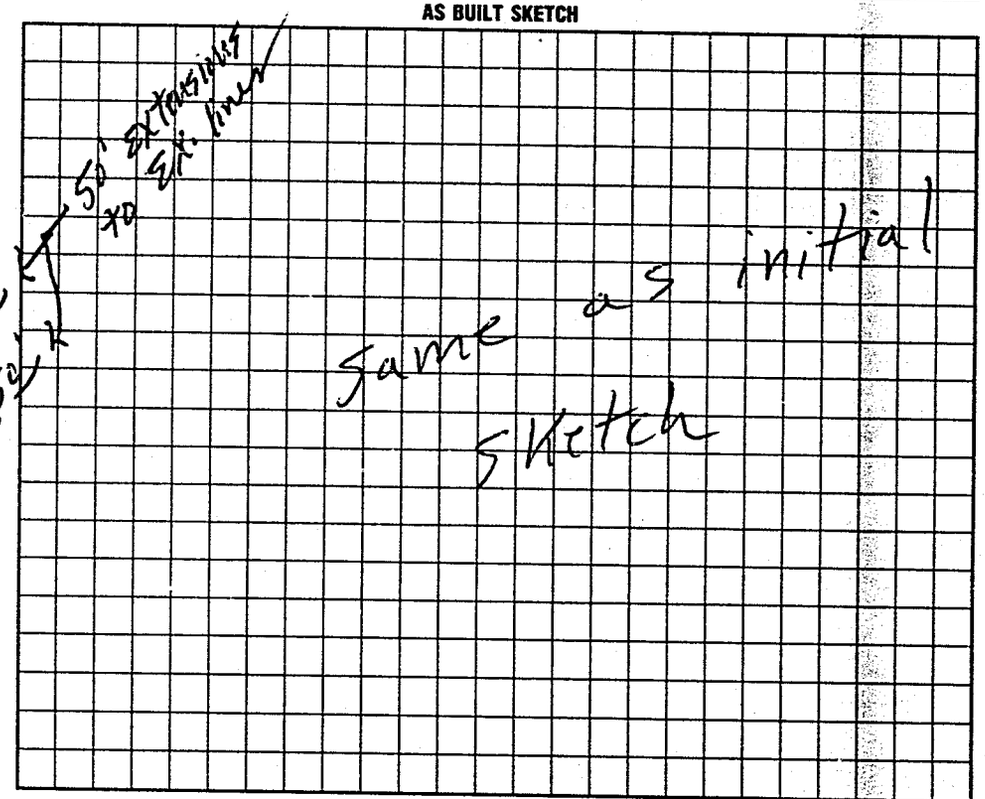

I understand that this permit can be suspended or revoked if any false information is supplied toward securing the permit/any unauthorized changes are made to the site/any unauthorized changes are made in the installation of the system. Improvement Permit is valid for 60 months from date of issuance.

Signed:

Improvement Permit by: F. C. Moore date 1-28-94

Existing System Inspection by: date

Installed by: James Hutlek

Certificate of Completion by: F. C. Moore date 2-1-94

Operation Permit by: date

HEALTH DEPT. COPY WHITE INSPECTION COPY (FINAL) GREEN OWNER COPY (FINAL) YELLOW INSPECTION COPY (INITIAL) PINK OWNER COPY (INITIAL) GOLD